

ADDENDUM NO. 1

DATE: February 16, 2023

TO: All Planholders

FROM: Tom Runkle
Project Manager

RE: Dickinson Park Sports Fields Renovations
Project No.: 21-1558

OWNER: St. Joseph Public Schools
2580 S. Cleveland Ave.
St. Joseph, MI 49085

The following items are changes and/or clarifications to the contract documents and shall be included in the Bid Proposal. All of these items will be part of the Contract Documents. The Bidder will acknowledge receipt of this Addendum in the appropriate space provided below and include this Addendum with their submitted bid. Failure to do so may result in disqualification of the bid.

Drawings: (all revisions have been clouded and tagged with a delta-1)

1. Sheet 2 - Topographic Survey
 - a. Add street names and school label.
 - b. Remove errant sewer pipe location.
2. Sheet 3 – Removals Plan
 - a. Add note to dispose of bleachers removed from concrete bleacher risers.
 - b. Add remove all existing infield stone surface note at baseball and softball fields.
 - c. Add remove tree notes.
 - d. Add existing storm sewer to remain note.
3. Sheet 4 – Overall Site Plan
 - a. Revise graphic scale.
4. Sheet 5 – Baseball Field Site Enlargement Plan
 - a. Revise graphic scale.
 - b. Revise Foul Pole locations.
5. Sheet 6 – Softball Field Site Enlargement Plan
 - a. Revise graphic scale.
 - b. Revise Foul Pole locations.

6. Sheet 7 – Overall Grading Plan
 - a. Revise graphic scale.
7. Sheet 8 – Baseball Field Grading Enlargement Plan
 - a. Revise graphic scale.
8. Sheet 9 – Softball Field Grading Enlargement Plan
 - a. Revise graphic scale.
9. Sheet 10 – Drainage and Utility Plan
 - a. Revise graphic scale.

Specifications: (all revisions are shown in bold italic type)

1. Section C-111 – Advertisement For Bids
 - a. Revise bid due date.
 - b. Eliminate reference to removal and construction dugout roofs (not in contract).
2. Section C-430 – Bid Bond
 - a. Revise bid due date.

Questions and Clarifications

1. Materials testing will be provided by Owner.
2. All permits shall be obtained and paid for by contractor. Anticipated permits:
 - i. SESC permit – County
 - ii. Building permit – City
 - iii. Electrical permit – Site Work
 - iv. Right of way permit – City
 - v. Plumbing Permit - City

Please acknowledge receipt of this addendum by signing below and attaching to the bid forms.

Should you have any questions or comments, please feel free to contact our office.


DATE

BIDDING FIRM

AUTHORIZED REPRESENTATIVE

Attachments: Revised Plan sheets and Specification Sections noted above.



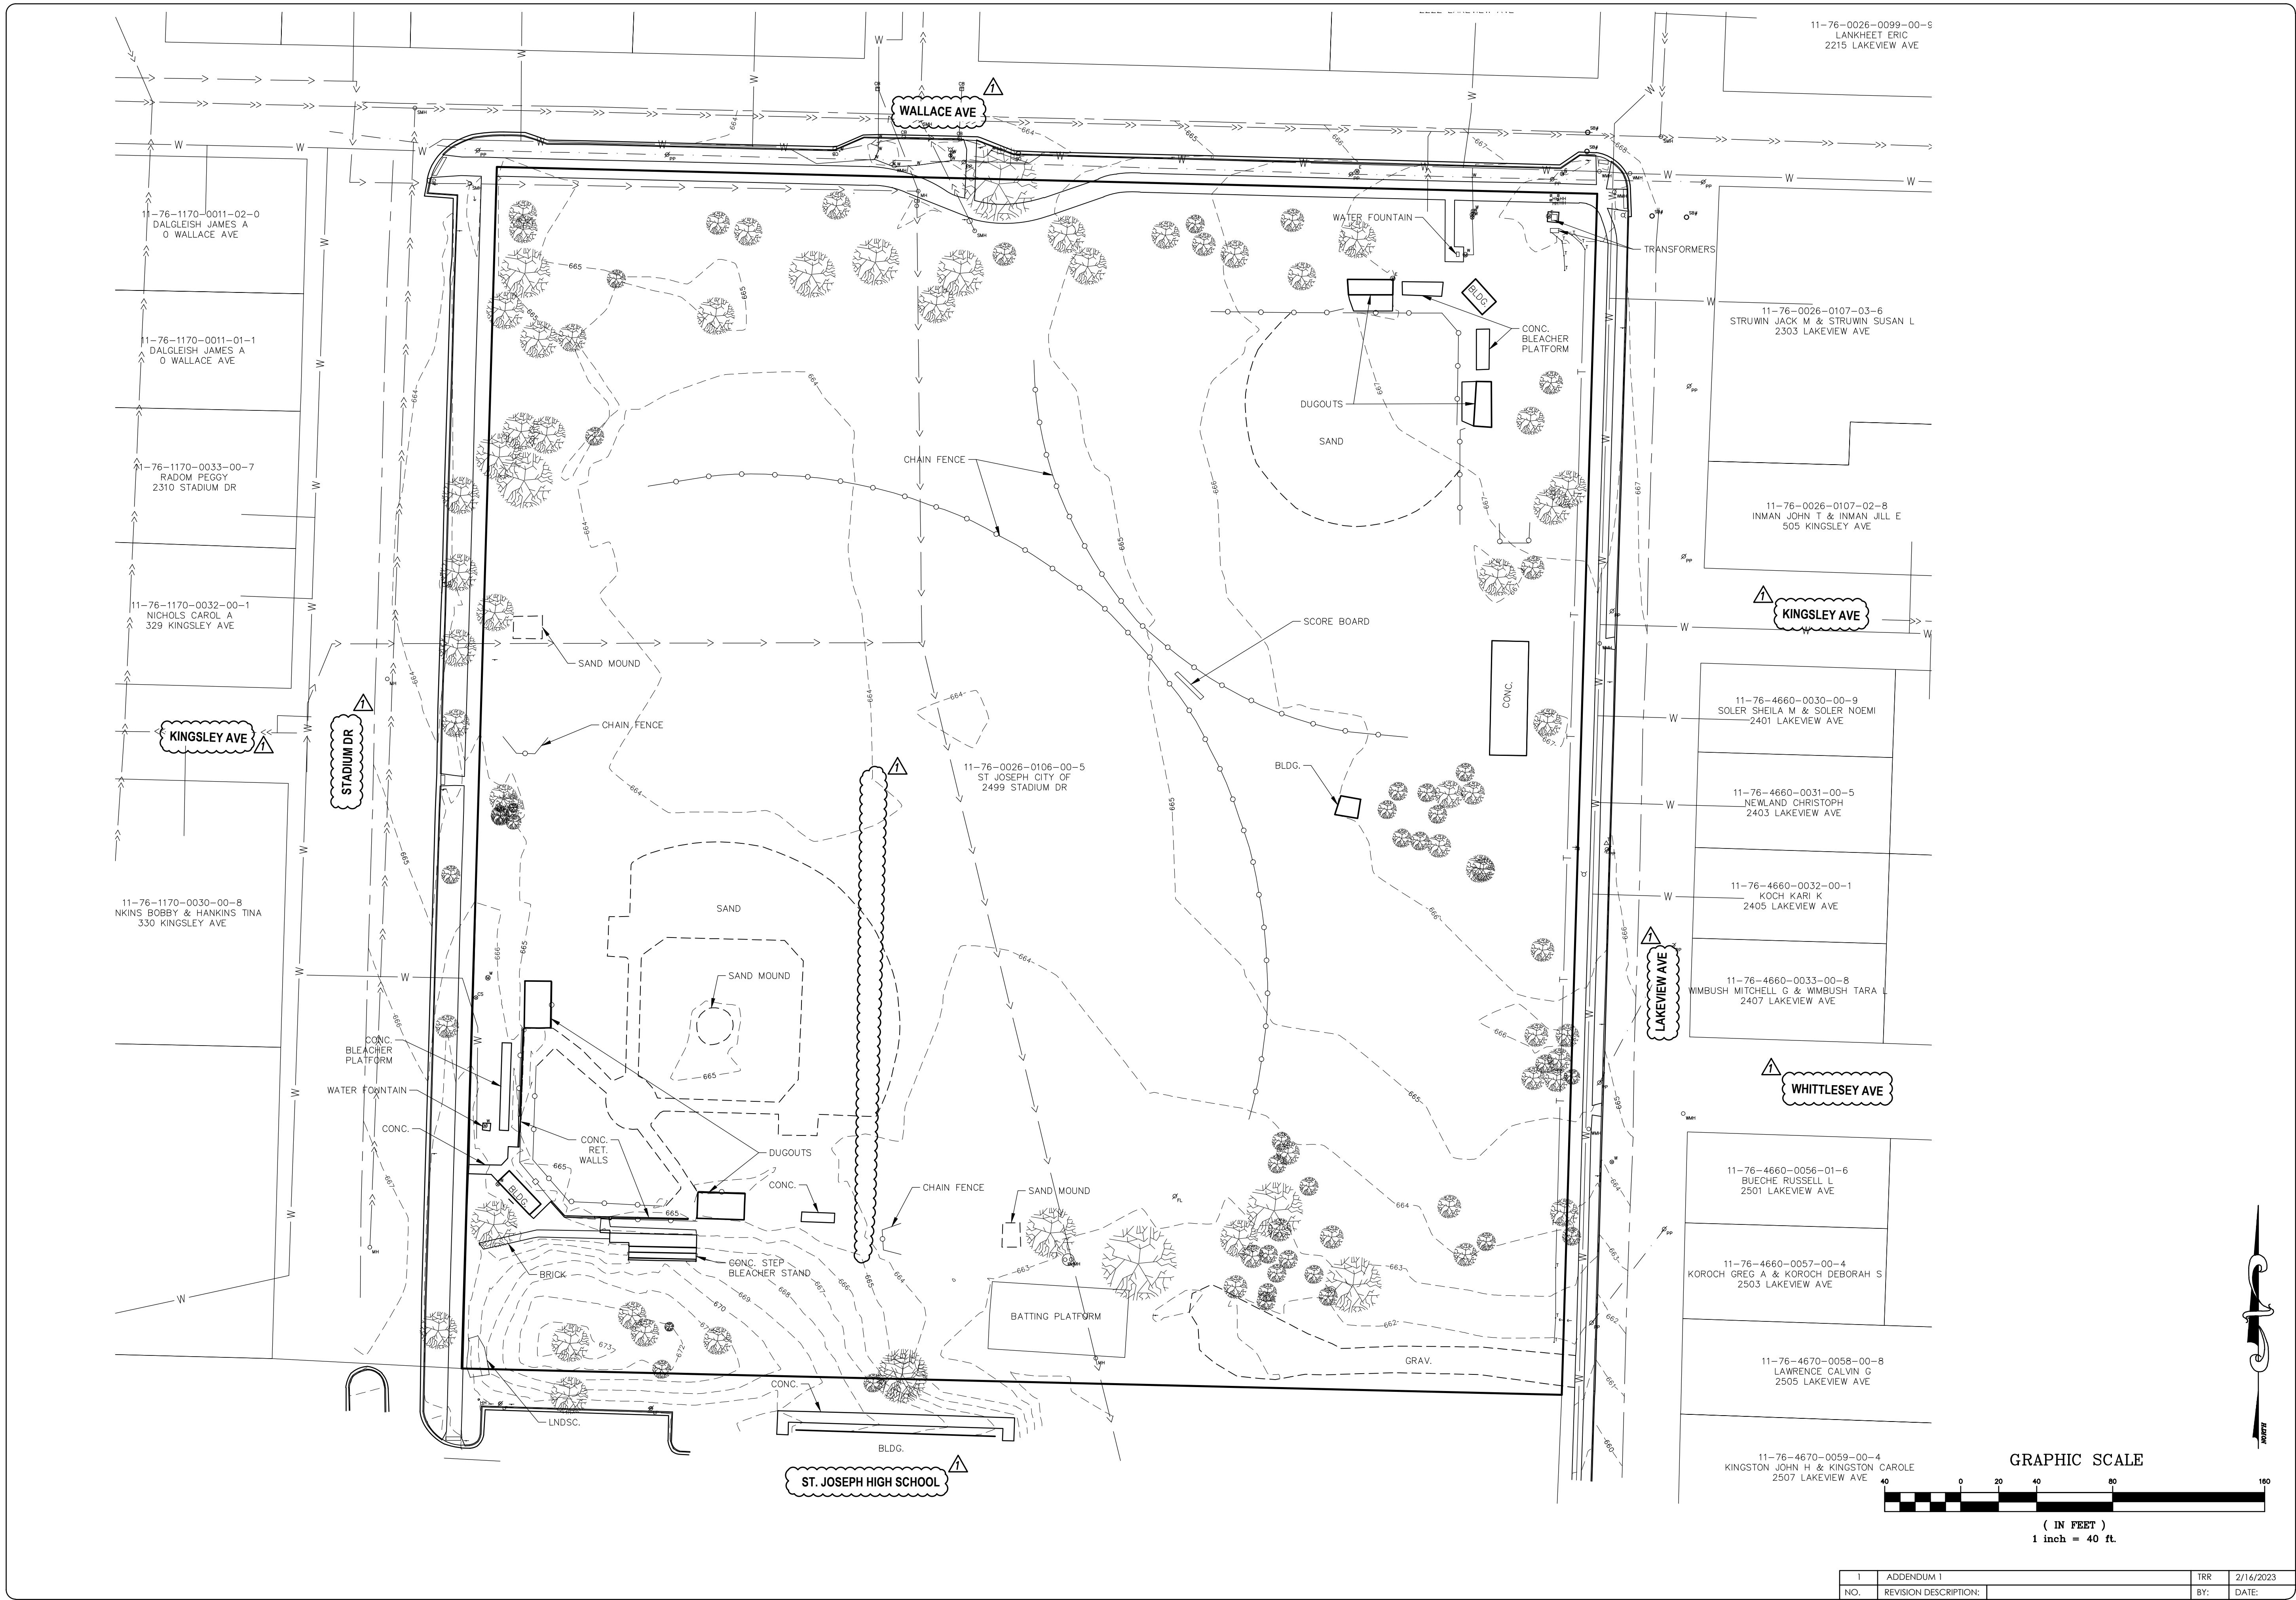

**ST. JOSEPH, MI
 DICKINSON PARK
 BALL FIELD RENOVATIONS**

TOPOGRAPHIC SURVEY

PROJECT:

SHEET TITLE:

DRAWN BY: **GOG**

DESIGNED BY:

PM REVIEW: **TRR**

QA/QC REVIEW:

DATE: **FEBRUARY 2022**

SEAL:

SIGNATURE:

DATE:

SCALE:
 HORIZ: 1" = 40'
 VERT: N/A

ACI JOB #
21-1558



SHEET NO.
2 of 15

NO.	REVISION DESCRIPTION:	TRR	DATE:
1	ADDENDUM 1		2/16/2023

C:\Projects\2021\21-1558 Dickinson Park Ball Field Renovations\CAD_C\1558Topo.dwg, 2/16/2023, 4:50 PM, mtrksh, 11



REMOVALS NOTES

1. THE DEPICTION OF UNDERGROUND UTILITIES HEREON SHOULD NOT BE CONSIDERED EXACT OR COMPLETE. CONTRACTOR TO EXERCISE CARE WHEN PERFORMING REMOVALS NEAR UNDERGROUND UTILITIES SHOWN AND CONFIRM LOCATIONS IN THE FIELD.
2. ALL PRIVATE UTILITIES (GAS, ELECTRIC, COMMUNICATIONS, ETC.) SHOWN TO BE REMOVED SHALL BE COORDINATED WITH THEIR RESPECTIVE UTILITY COMPANIES.
3. THE UTILITY COMPANY SHALL PROVIDE FINAL DIRECTION ON MEANS AND METHODS OF REMOVAL AND DISCONNECTION. ALL TREES INTENDED TO REMAIN SHALL BE PROTECTED DURING CONSTRUCTION. DO NOT STORE MATERIALS OR EXCAVATE WITHIN DRIPLINE.
4. ALL MATERIALS TO BE SALVAGED SHALL BE STORED ON SITE AT A LOCATION DETERMINED OWNER.
5. COORDINATE ALL ELECTRICAL CIRCUIT REWORKING WITH OWNER PRIOR TO DEMOLITION.
6. CONTRACTOR TO ORGANIZE A DEMOLITION COORDINATION MEETING WITH THE OWNER PRIOR TO BEGINNING REMOVALS.
7. ALL SAWCUTS NECESSARY FOR PAVEMENT REMOVALS SHALL BE PERFORMED PRIOR TO PAVEMENT REMOVAL.
8. ALL ITEMS NOTED TO BE REMOVED AND NOT SALVAGED SHALL INCLUDE LEGAL OFF-SITE DISPOSAL.

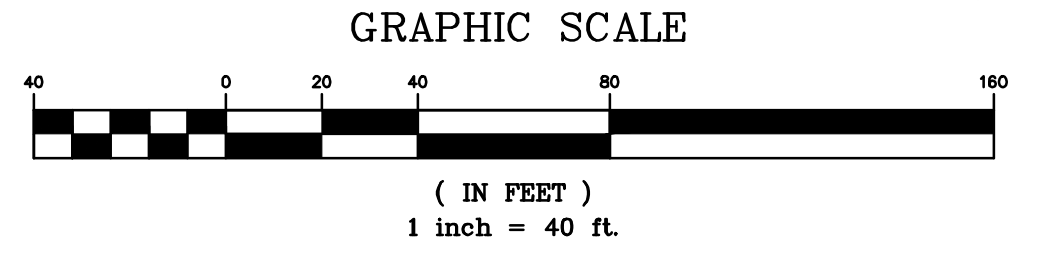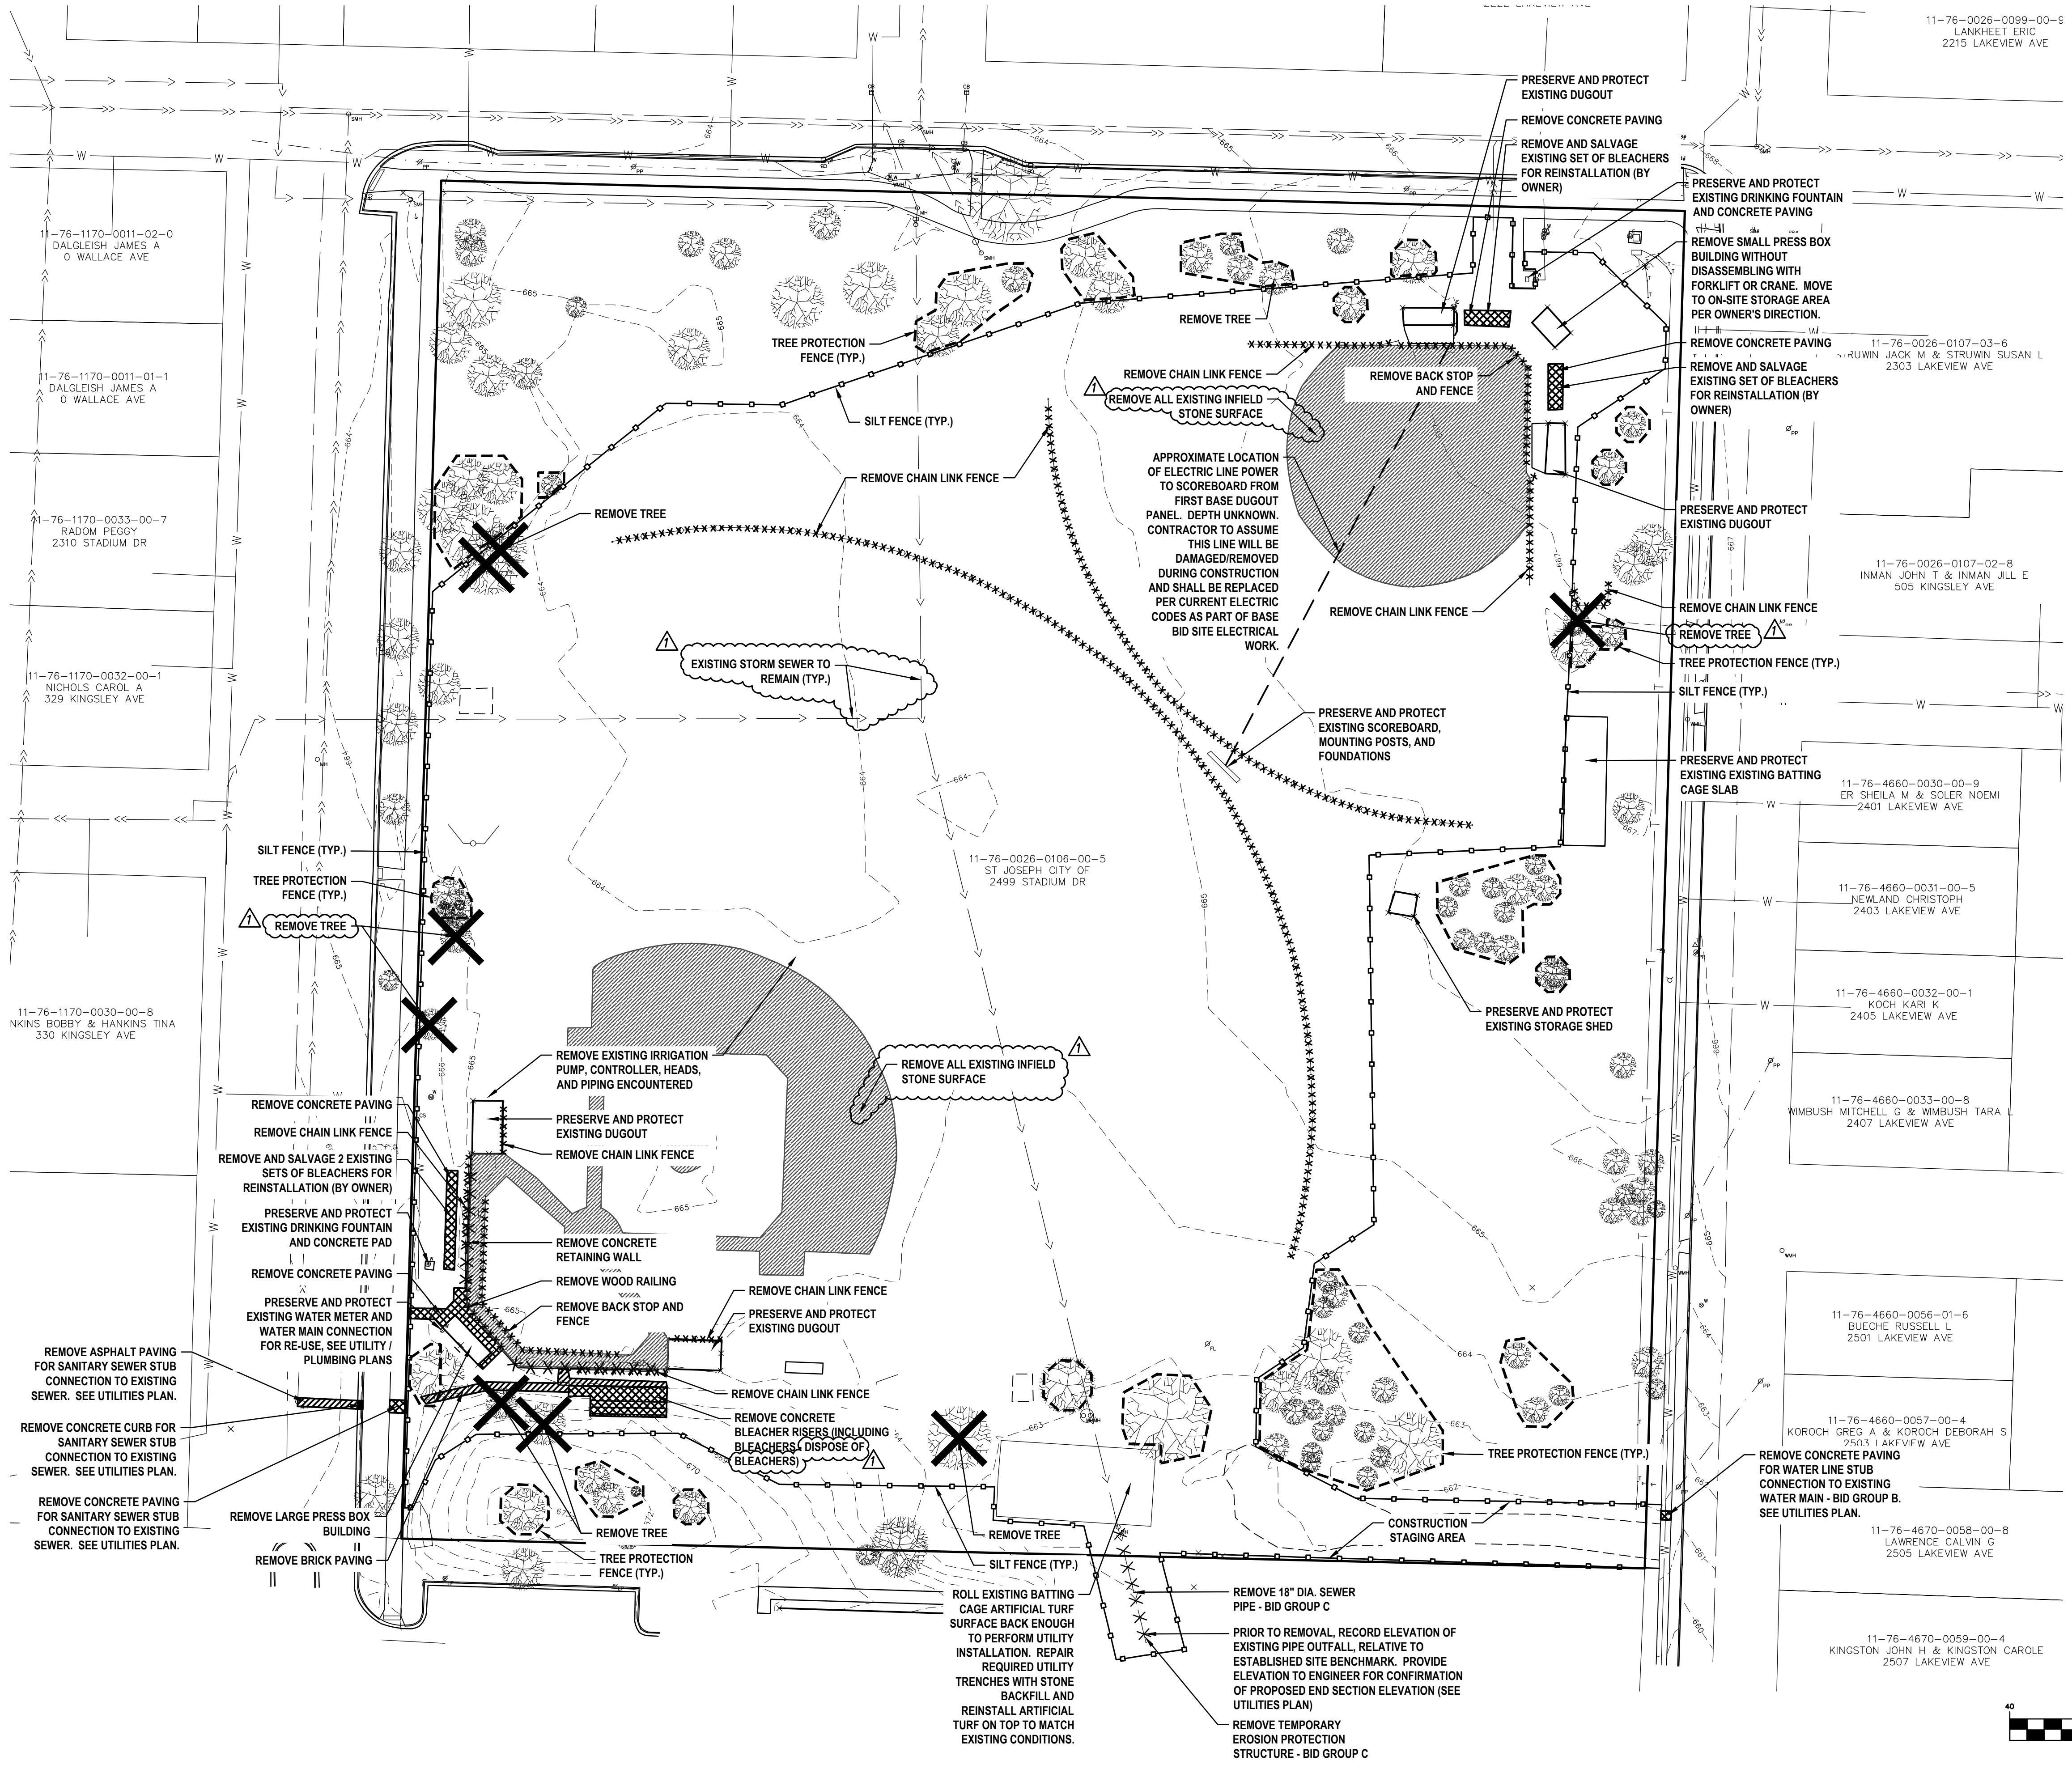

1	ADDENDUM 1	TRR	2/16/2023
NO.	REVISION DESCRIPTION:	BY:	DATE:

C:\Projects\2021\21-1558 Dickinson Park Sports Fields Renovations\CAD_C\12\Drawings\FINAL\DISKON21-1558-RENOV.PLA.dwg, 2/16/2023 3:51:14 AM, vtabler, 1:1

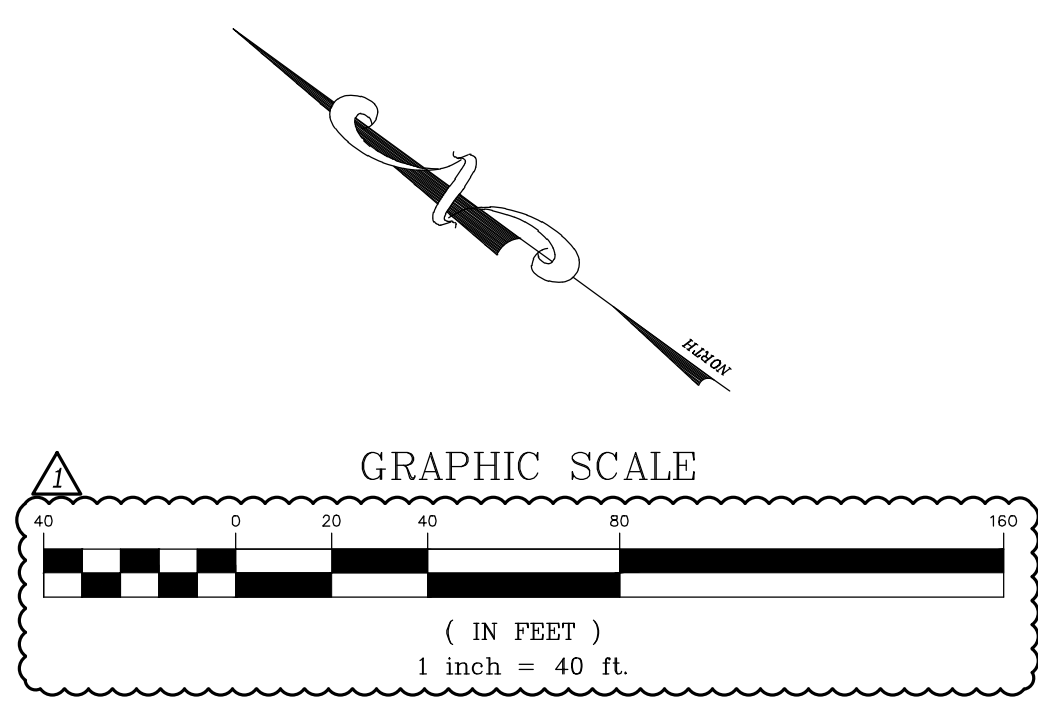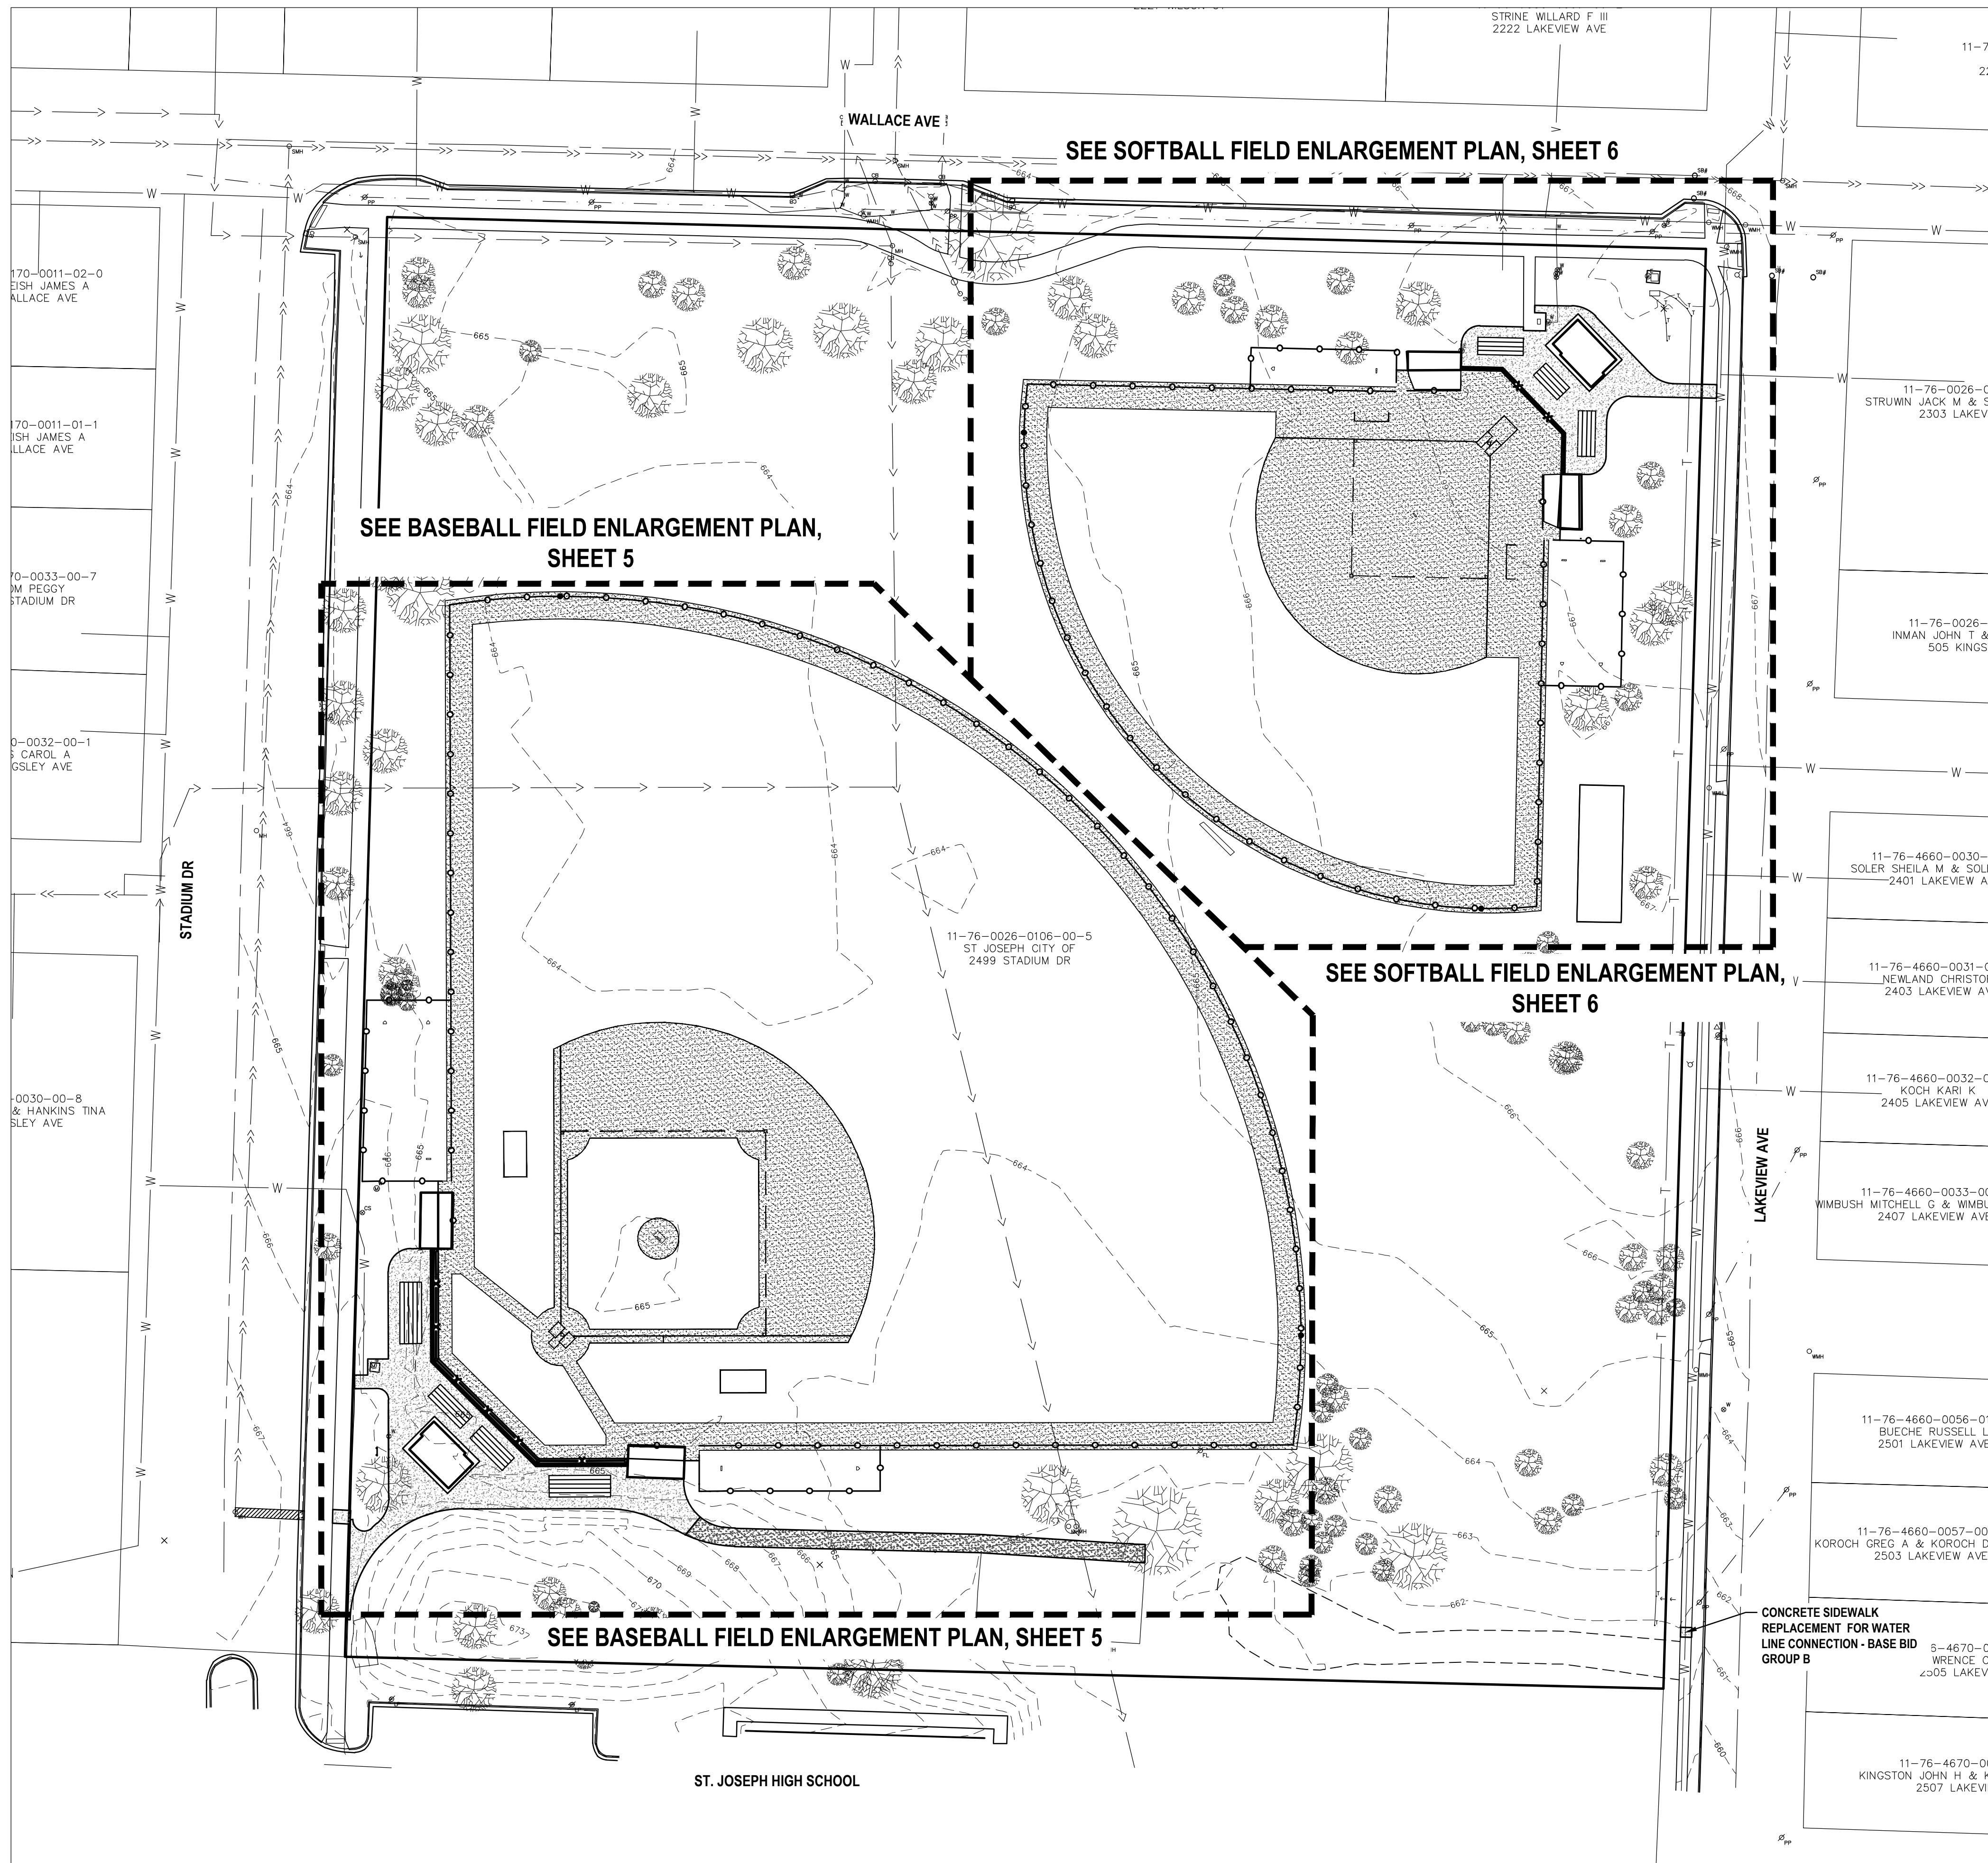

ABONMARCHÉ
 265 West Main Street
 Benton Harbor, MI 49703
 T 269.927.2293
 F 269.927.1017
 abonmarche.com
 COPYRIGHT © 2011 - ABONMARCHÉ CONSULTANTS, INC.
 Benjamen Harbor
 Earl Warren
 Cochran
 Hobart
 Lombardi
 Engineering - Architecture - Land Surveying

**DICKINSON PARK
 SPORTS FIELDS RENOVATIONS
 ST JOSEPH, MI**

OVERALL SITE PLAN

SHEET TITLE:
 DRAWN BY: TR
 DESIGNED BY: TR
 PM REVIEW: TR
 QA/QC REVIEW:
 DATE: 2/3/2022
 SEAL:

SIGNATURE:
 DATE:

HARD COPY IS INTENDED TO BE 24" X 36" WHEN PLOTTED. SCALE(S) INDICATED AND GRAPHIC QUALITY MAY NOT BE ACCURATE FOR ANY OTHER SIZES

SCALE:
 HORZ: AS NOTED
 VERT:

ACI JOB #


21-1558

SHEET NO.

4 of 15

1	ADDENDUM 1	TRR	2/16/2023
NO.	REVISION DESCRIPTION:	BY:	DATE:


C:\Projects\2021\21-1558 Dickinson Park Sports Fields Renovations\CAD_C310\Drawings\FINAL DESIGN\21-1558 SITE.Plot - OVERALL_210323.dwg, 2/16/2023, 8:46:00 AM, mtrk11

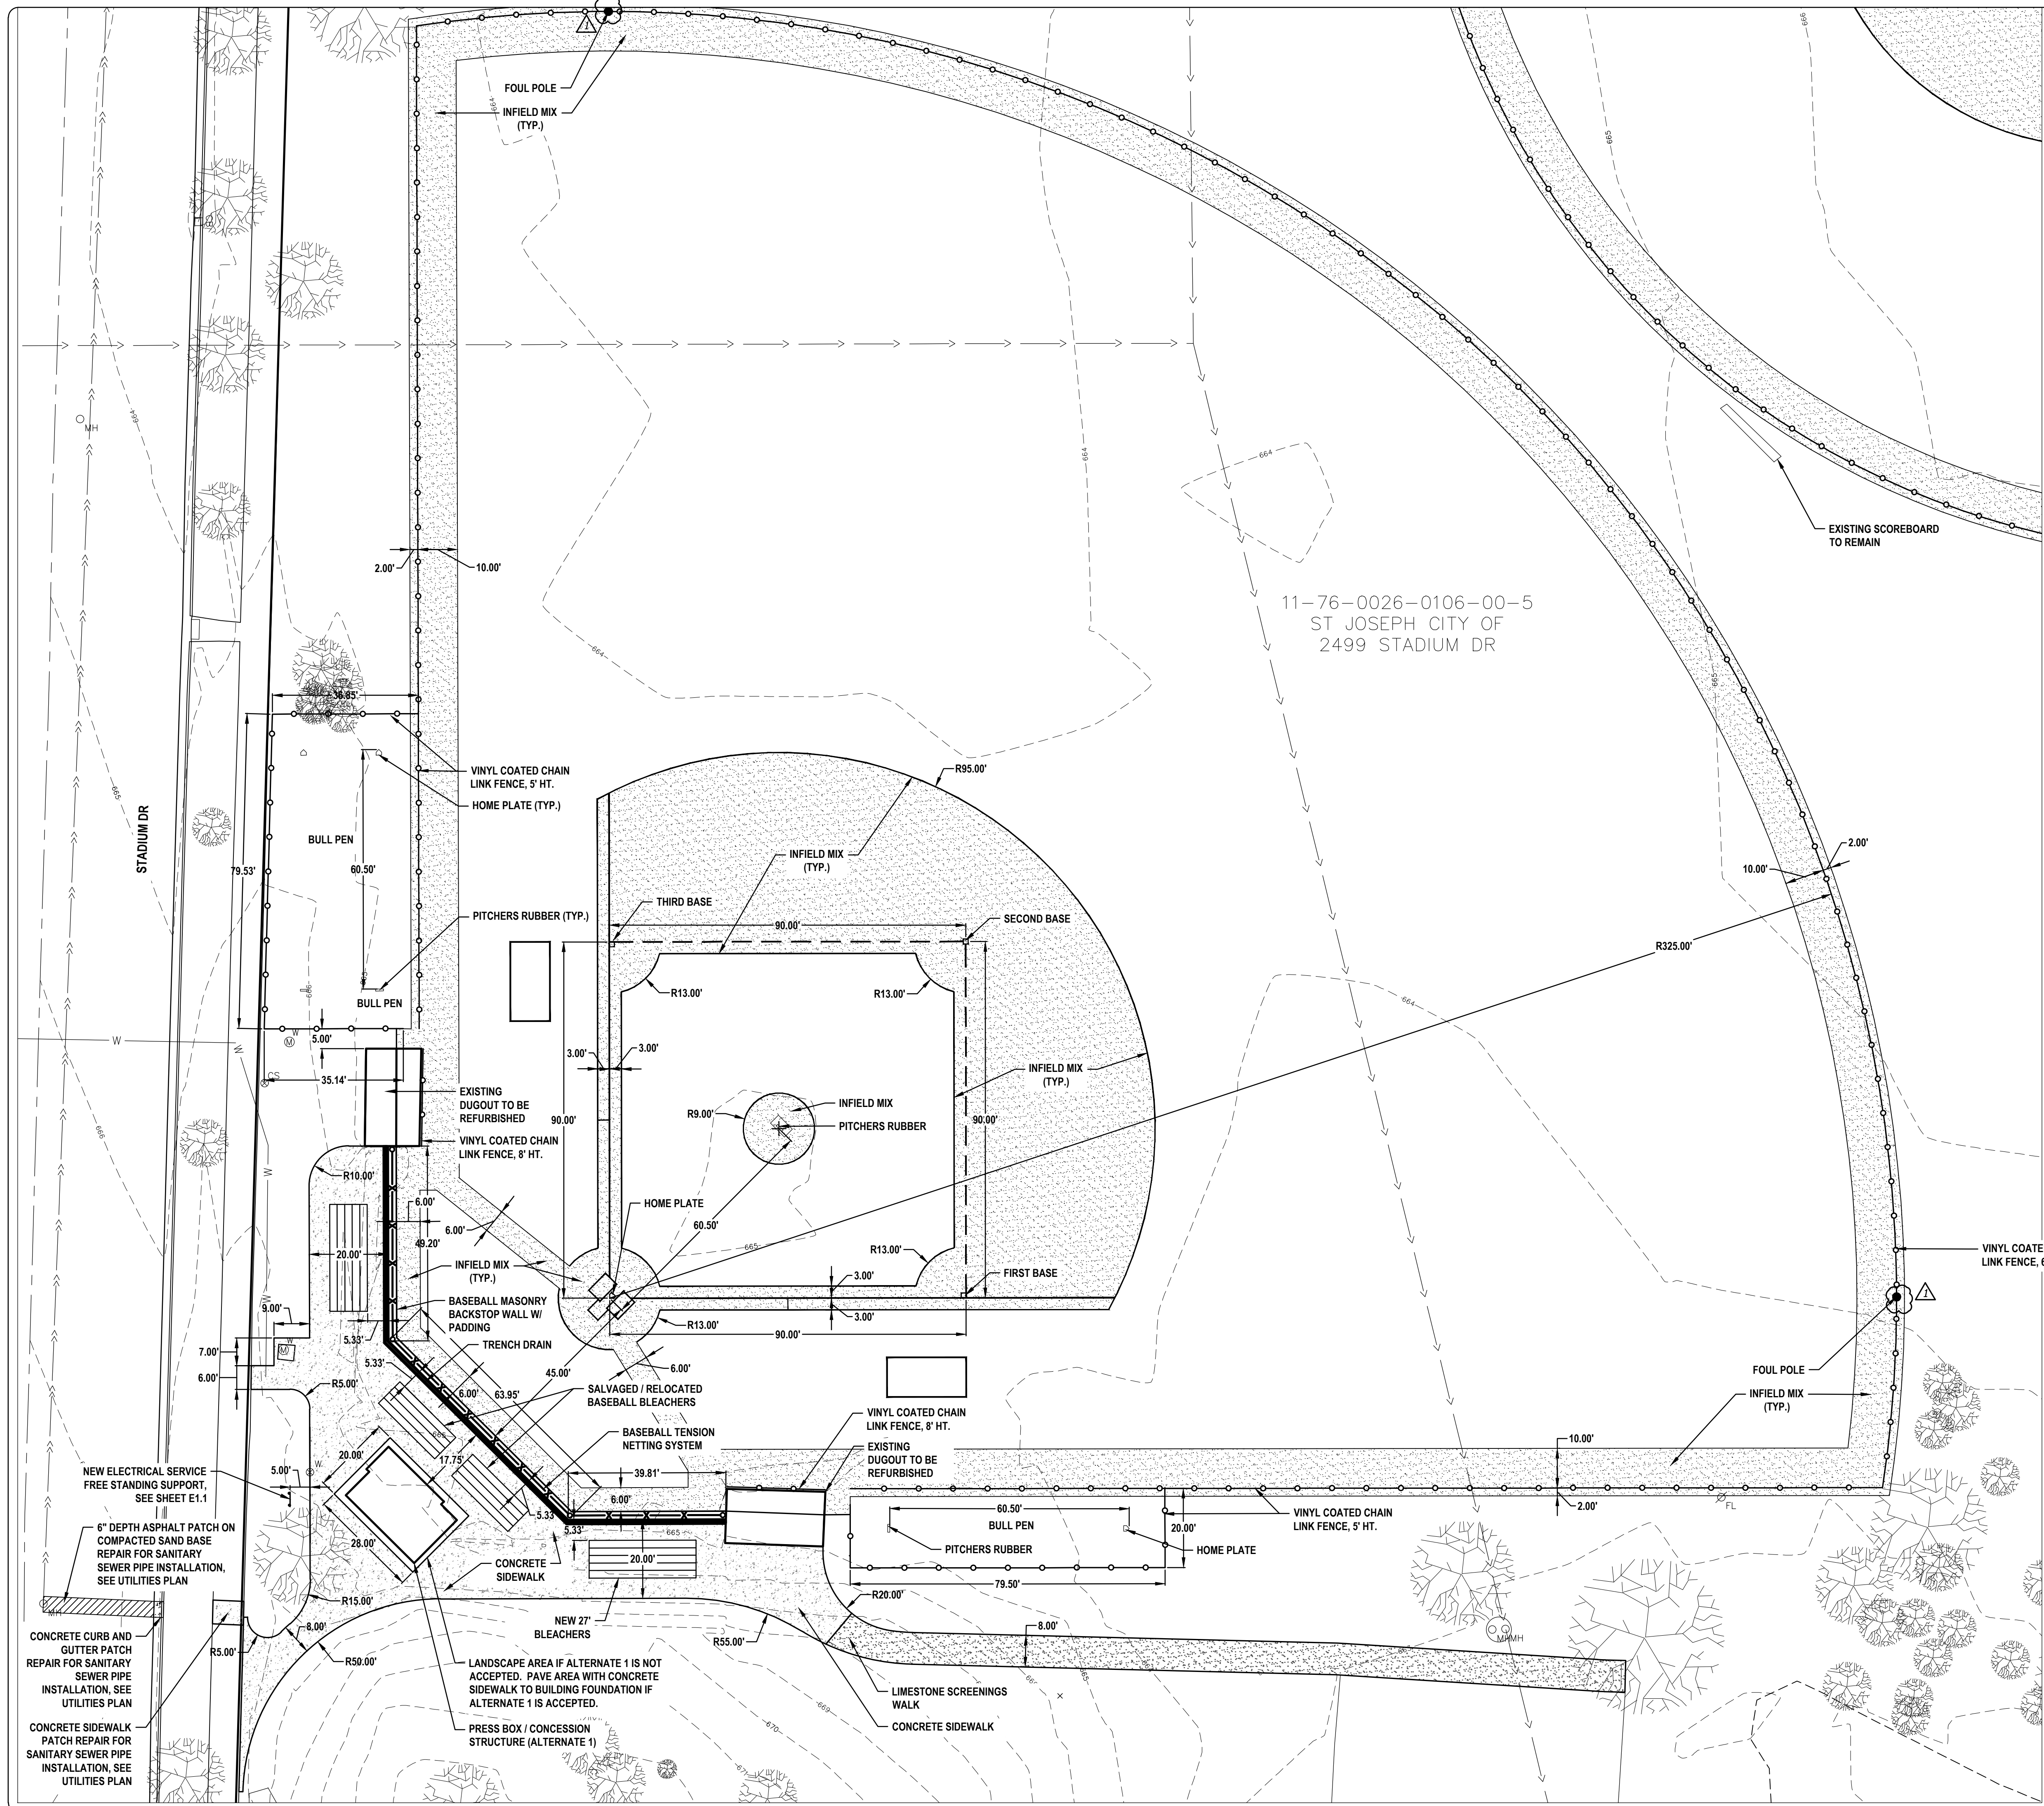

11-76-0026-0106-00-5
ST JOSEPH CITY OF
2499 STADIUM DR

NOTES

1. PRESS BOX / CONCESSION STRUCTURE LOCATION SHALL BE ENTIRELY CONCRETE SIDEWALK IF ALTERNATE 1 IS NOT ACCEPTED.
2. ALL RADI FORMED FOR CONCRETE SIDEWALK CURVES SHALL BE SMOOTH AND CONTINUOUS. CURVES THAT ARE SEGMENTED, NON-CONTINUOUS, OR OF DIFFERING DIMENSIONS THAN THOSE NOTED WILL BE REJECTED.
3. RECOMMENDED FIELD RESTORATION CONTRACTOR:
TURF SERVICES
17205 148TH AVE
SPRING LAKE, MI 49456
616-842-4975
TURFSERV@12K.COM
OR EQUAL

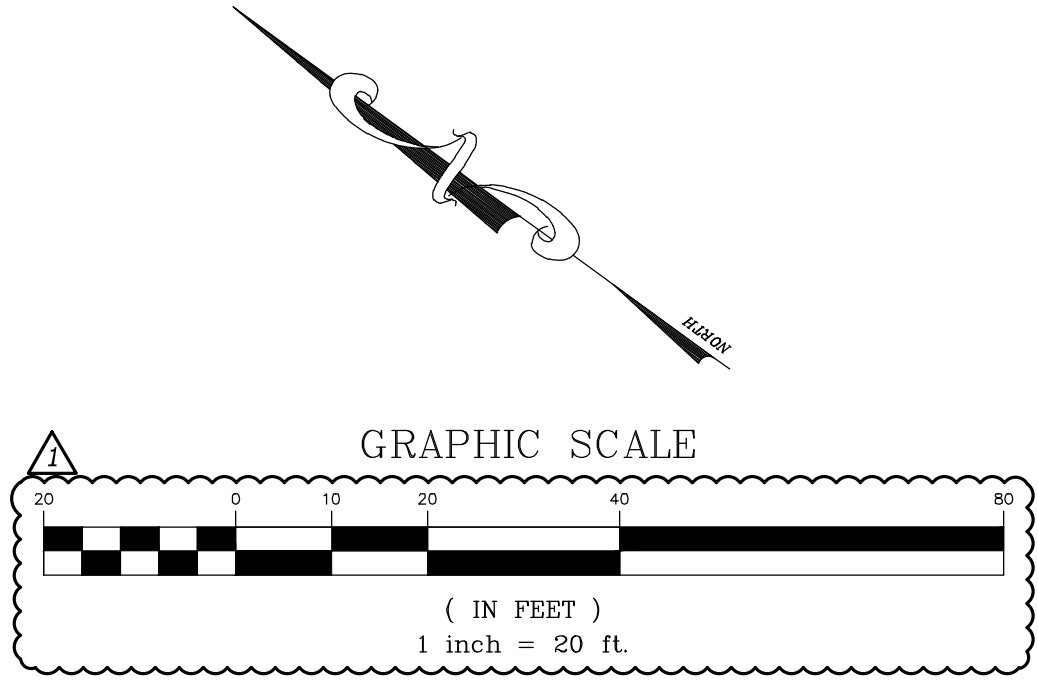

ABONMARCHÉ
 Benoit Hamoir
 Eric Warron
 Colleen
 Hobart
 Lorraine
 Engineering - Architecture - Land Surveying
 245 West Main Street
 Benton Harbor, MI 49723
 T 269.927.2293
 F 269.927.1017
 abonmarche.com
 COPYRIGHT 2011 - ABONMARCHÉ CONSULTANTS, INC.


DICKINSON PARK
SPORTS FIELDS RENOVATIONS
ST JOSEPH, MI

BASEBALL FIELD SITE
ENLARGEMENT PLAN

SHEET TITLE:
 DRAWN BY: TR
 DESIGNED BY: TR
 PM REVIEW: TR
 QA/QC REVIEW:
 DATE: 2/3/2022
 SEAL:

SIGNATURE:
 DATE:
 SCALE:
 HORIZ: AS NOTED
 VERT:
 ACI JOB #
 21-1558
 SHEET NO.


1	ADDENDUM 1	TRR	2/16/2023
NO.	REVISION DESCRIPTION:	BY:	DATE:

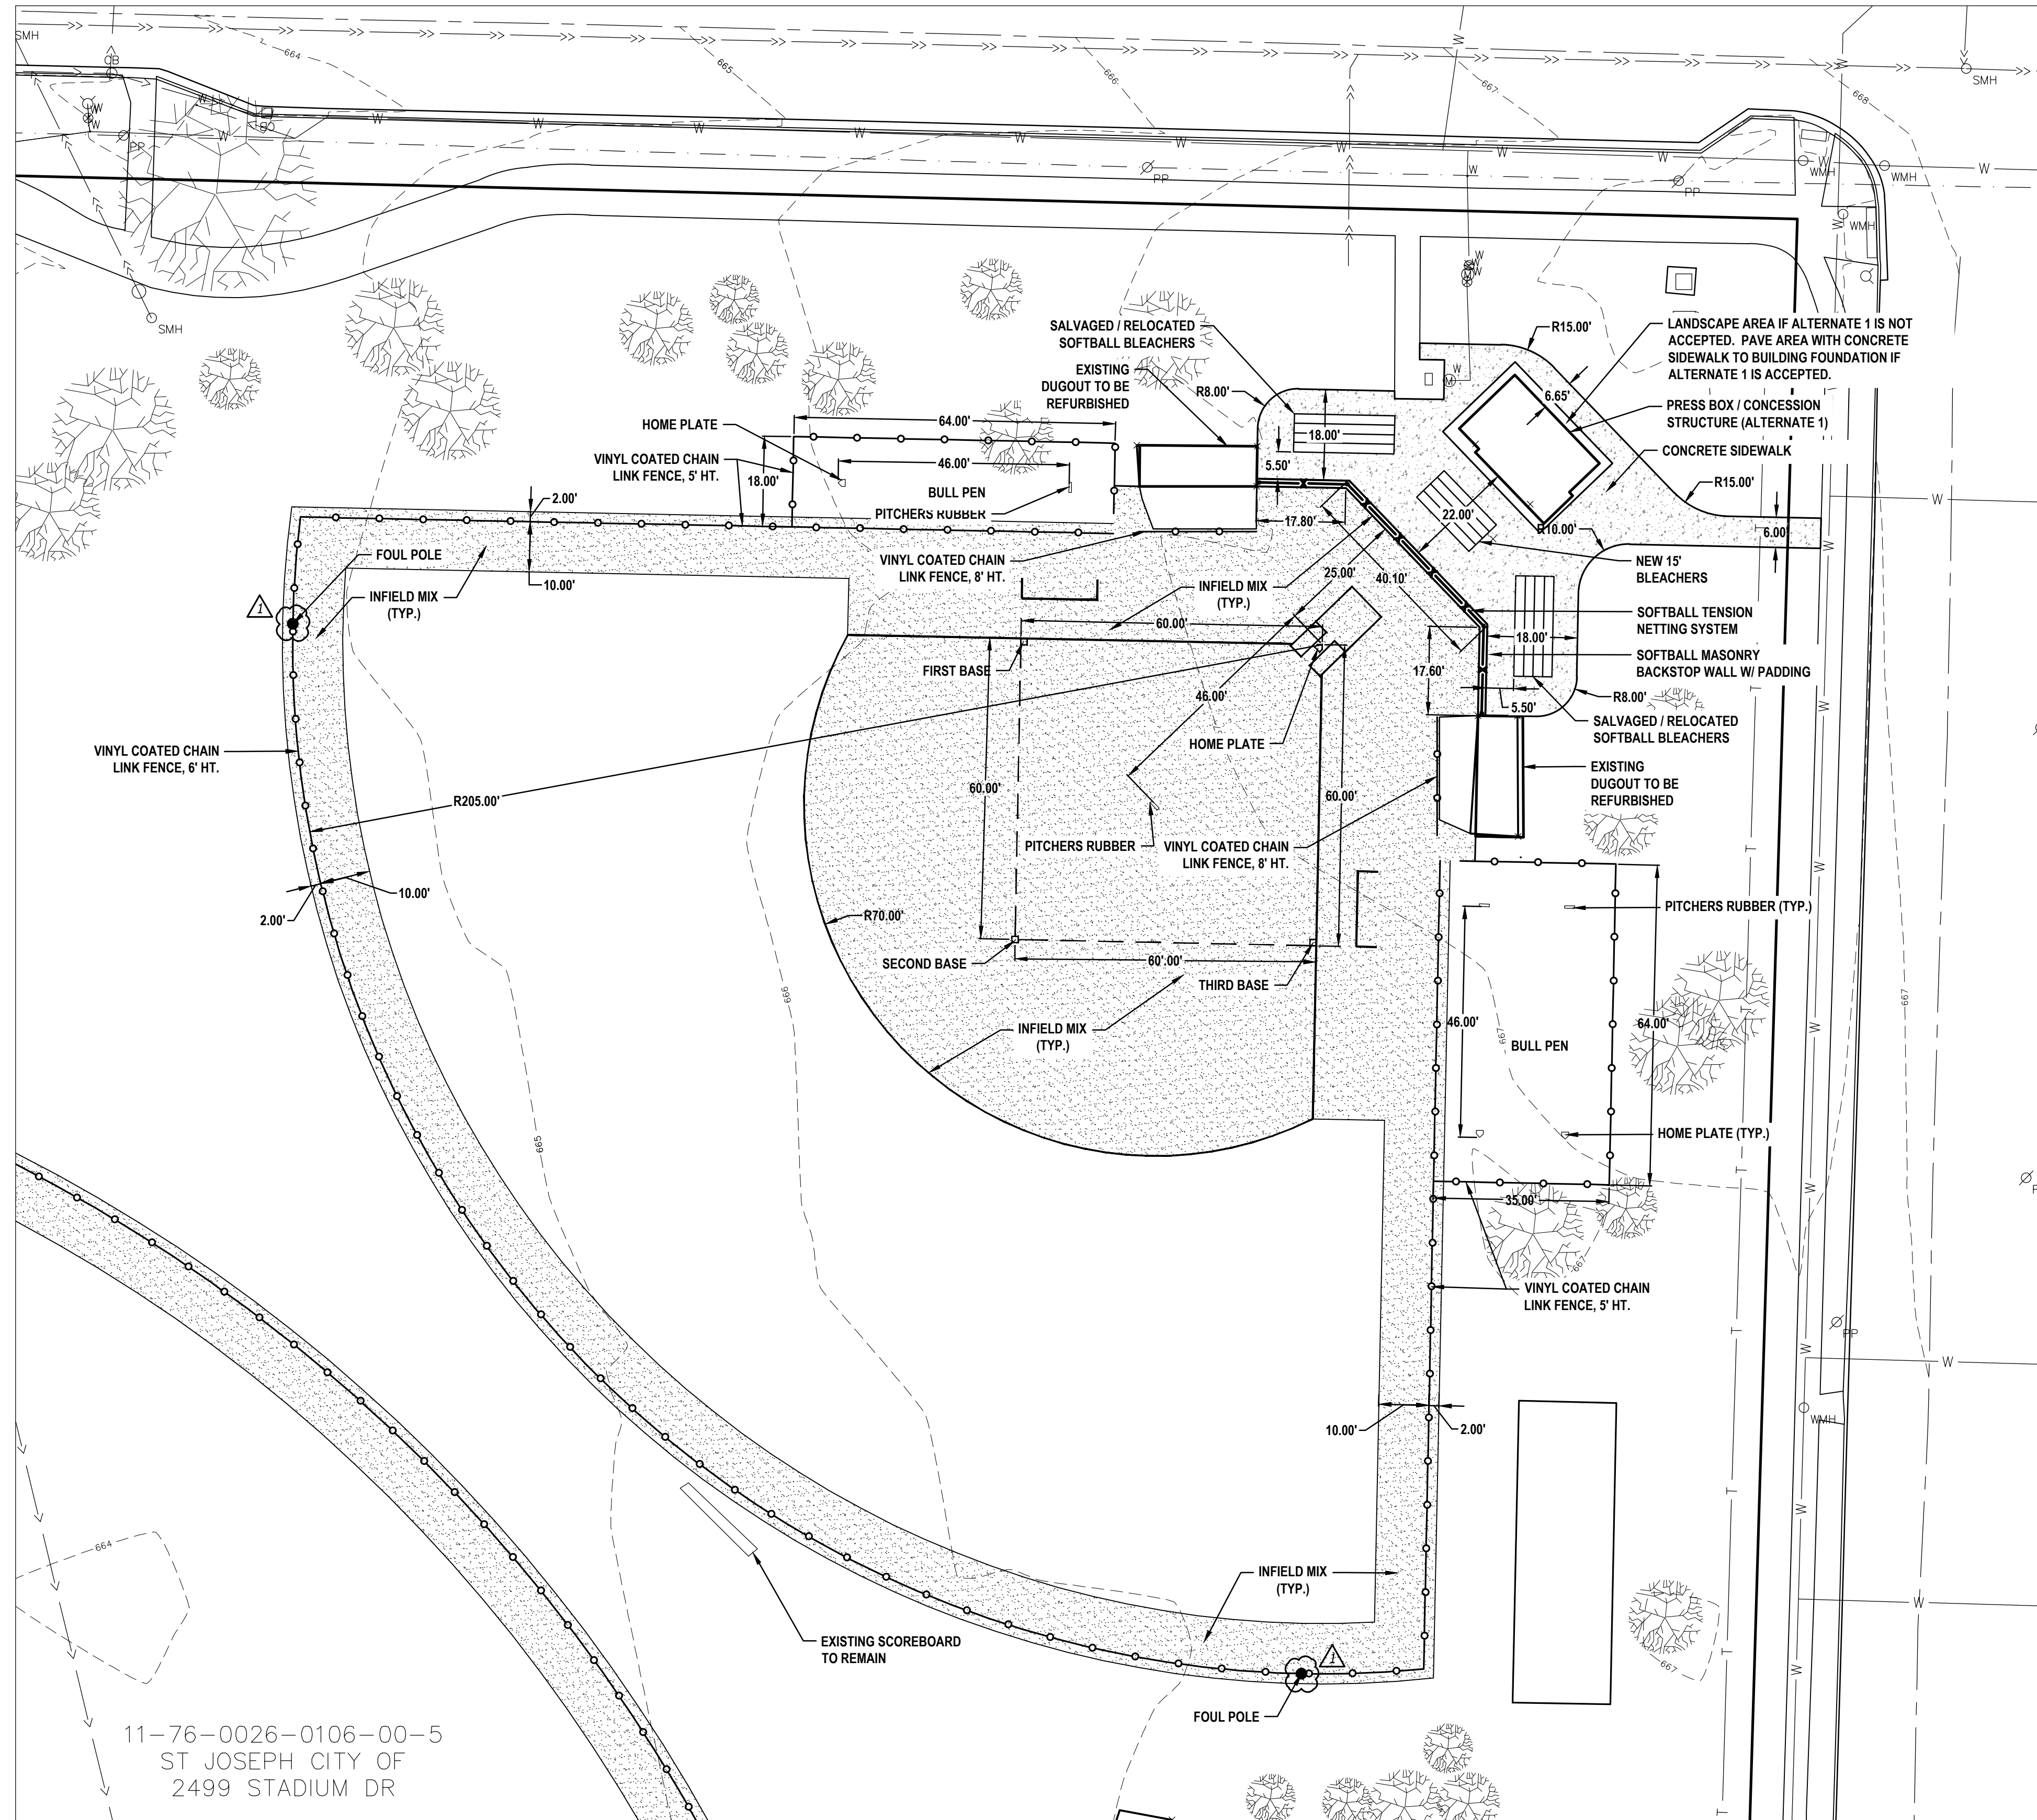



11-76-0026-0106-00-5
ST JOSEPH CITY OF
2499 STADIUM DR

NOTES


1. PRESS BOX / CONCESSION STRUCTURE LOCATION SHALL BE ENTIRELY CONCRETE SIDEWALK IF ALTERNATE 1 IS NOT ACCEPTED.
2. ALL RADII FORMED FOR CONCRETE SIDEWALK CURVES SHALL BE SMOOTH AND CONTINUOUS. CURVES THAT ARE SEGMENTED, NON-CONTINUOUS, OR OF DIFFERING DIMENSIONS THAN THOSE NOTED WILL BE REJECTED.
3. RECOMMENDED FIELD RESTORATION CONTRACTOR:
TURF SERVICES
17205 148TH AVE
SPRING LAKE, MI 49456
616-842-4975
TURFSERV@GK.COM
OR EQUAL

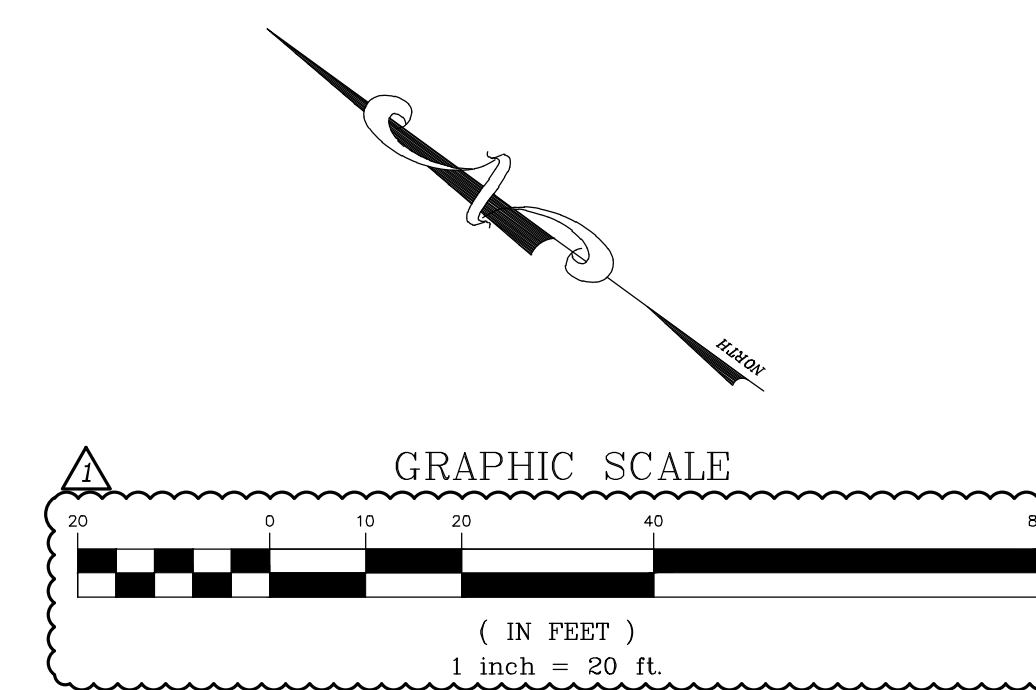

1	ADDENDUM 1	TRR	2/16/2023
NO.	REVISION DESCRIPTION:	BY:	DATE:

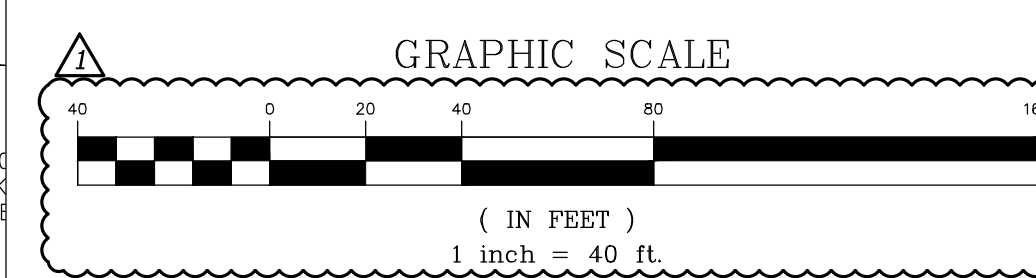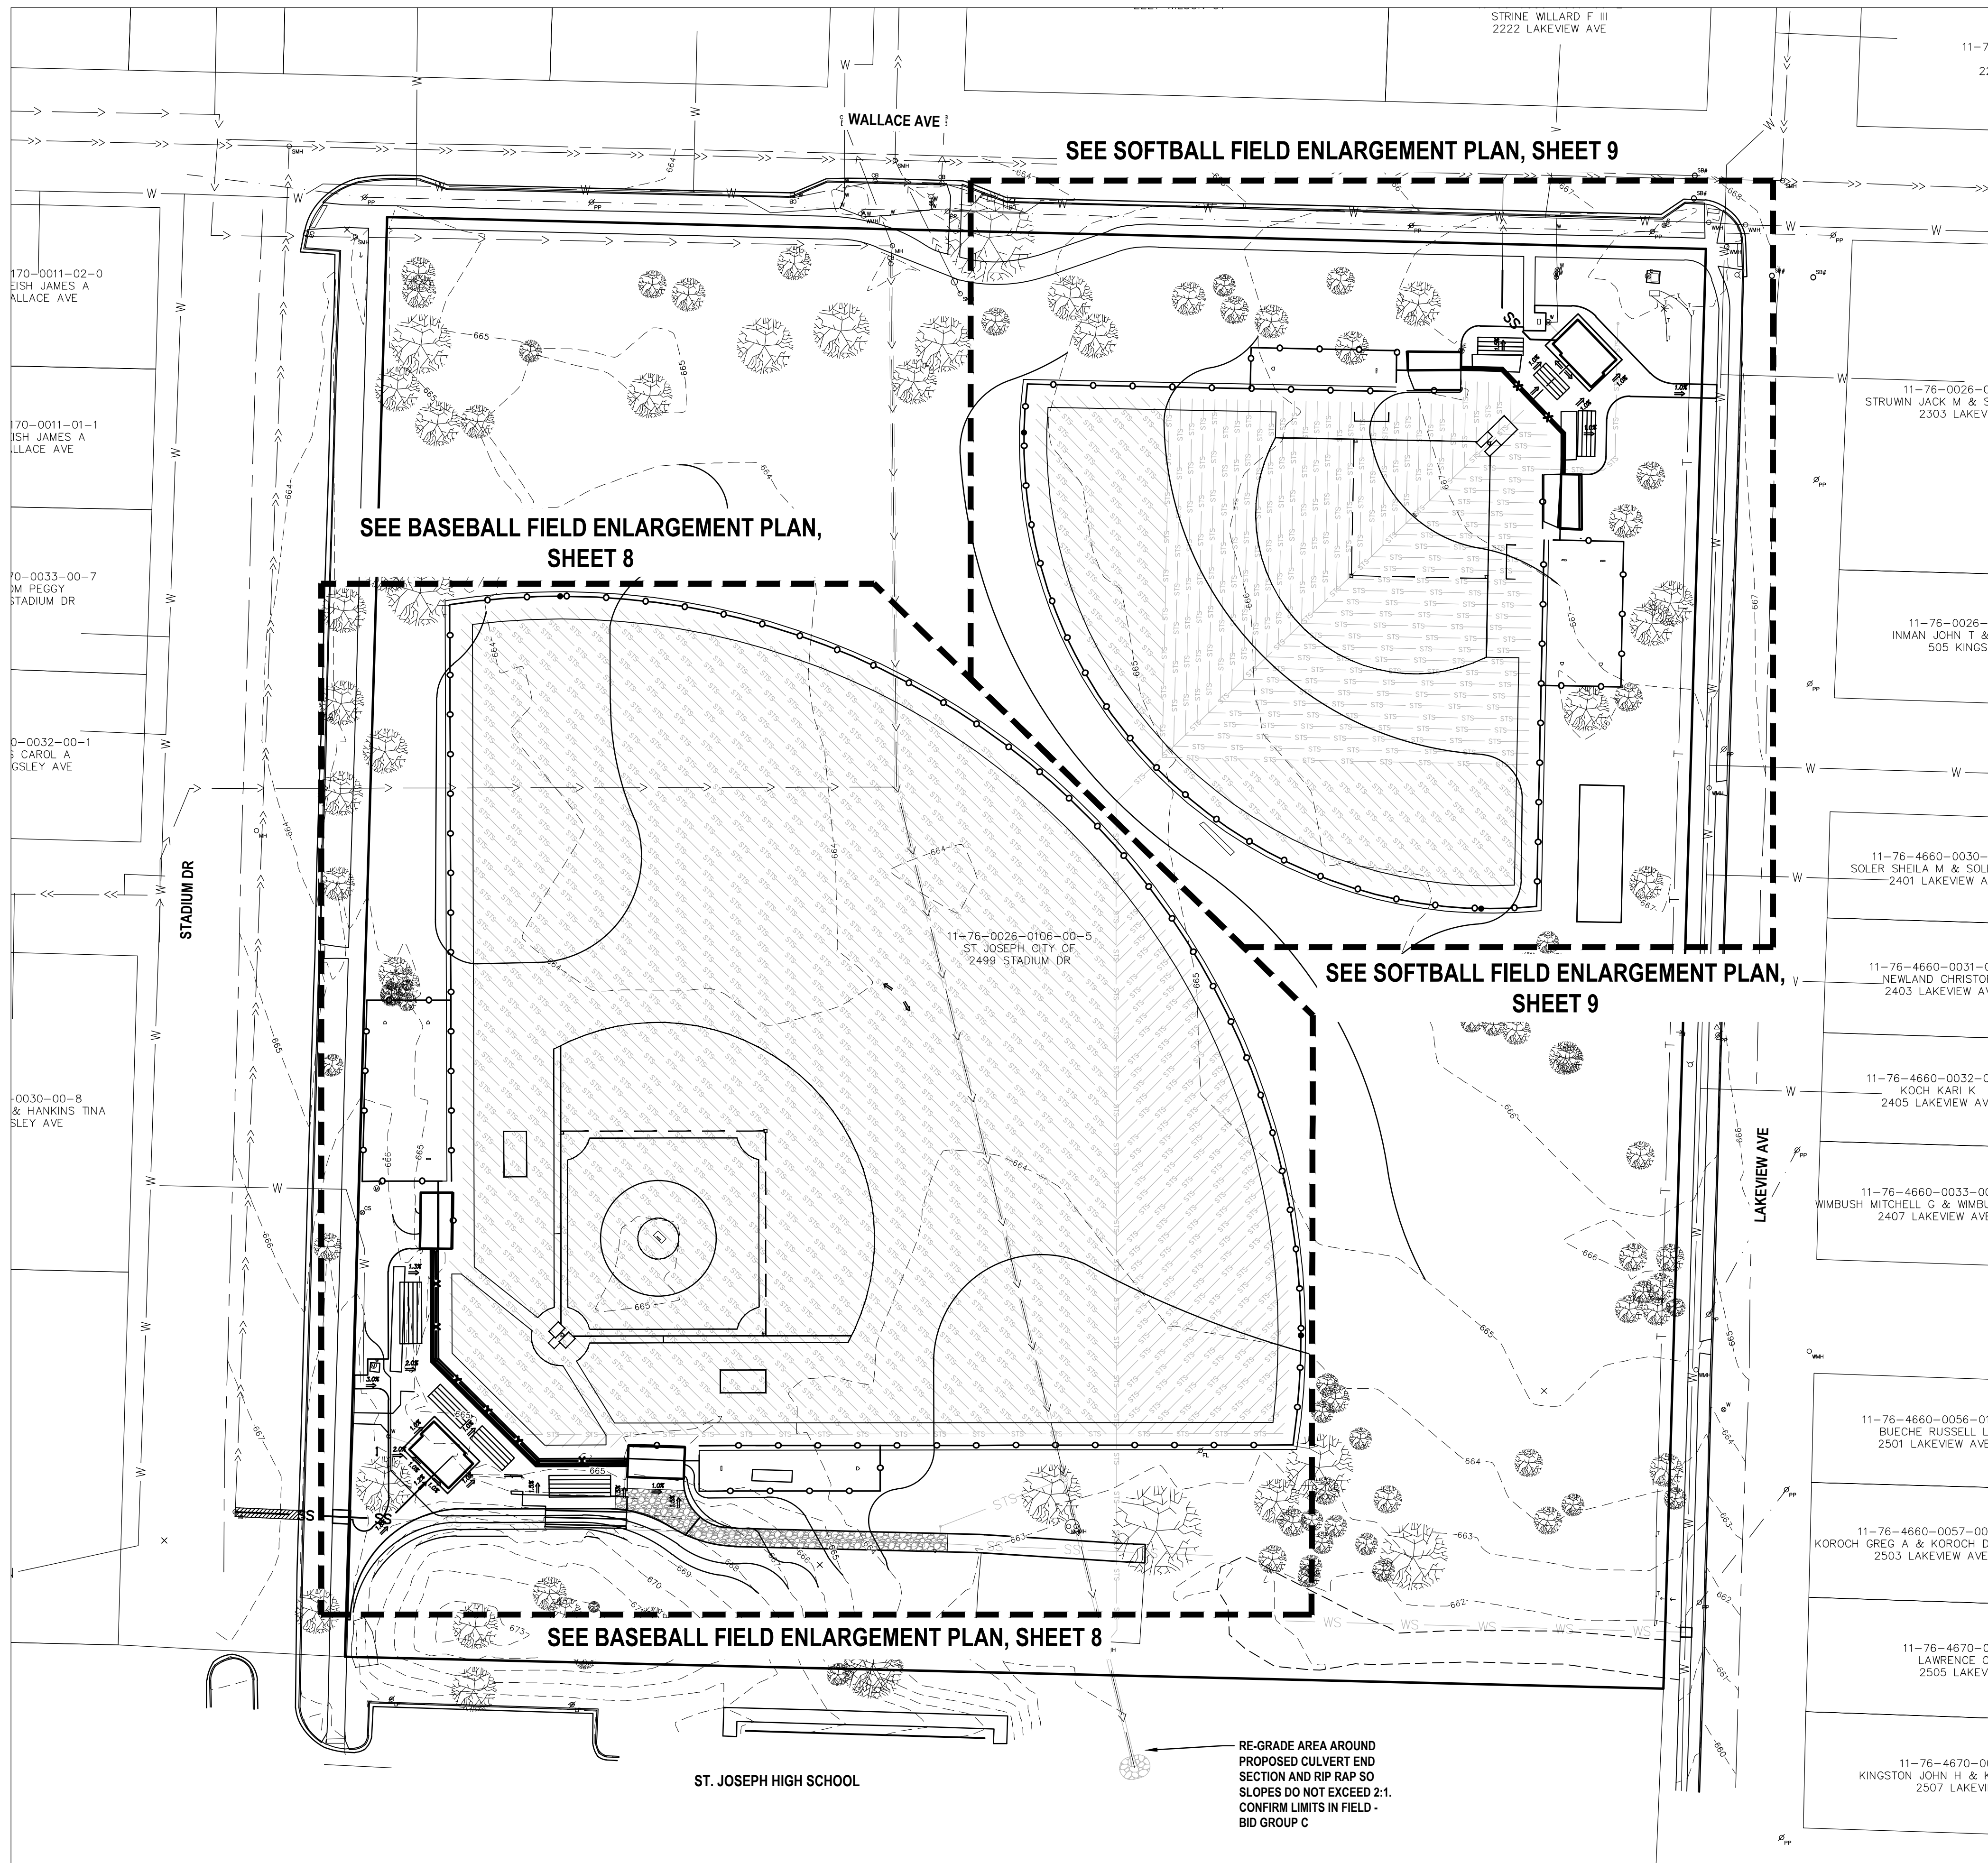

1	ADDENDUM 1	TRR	2/16/2023
NO.	REVISION DESCRIPTION:	BY:	DATE:

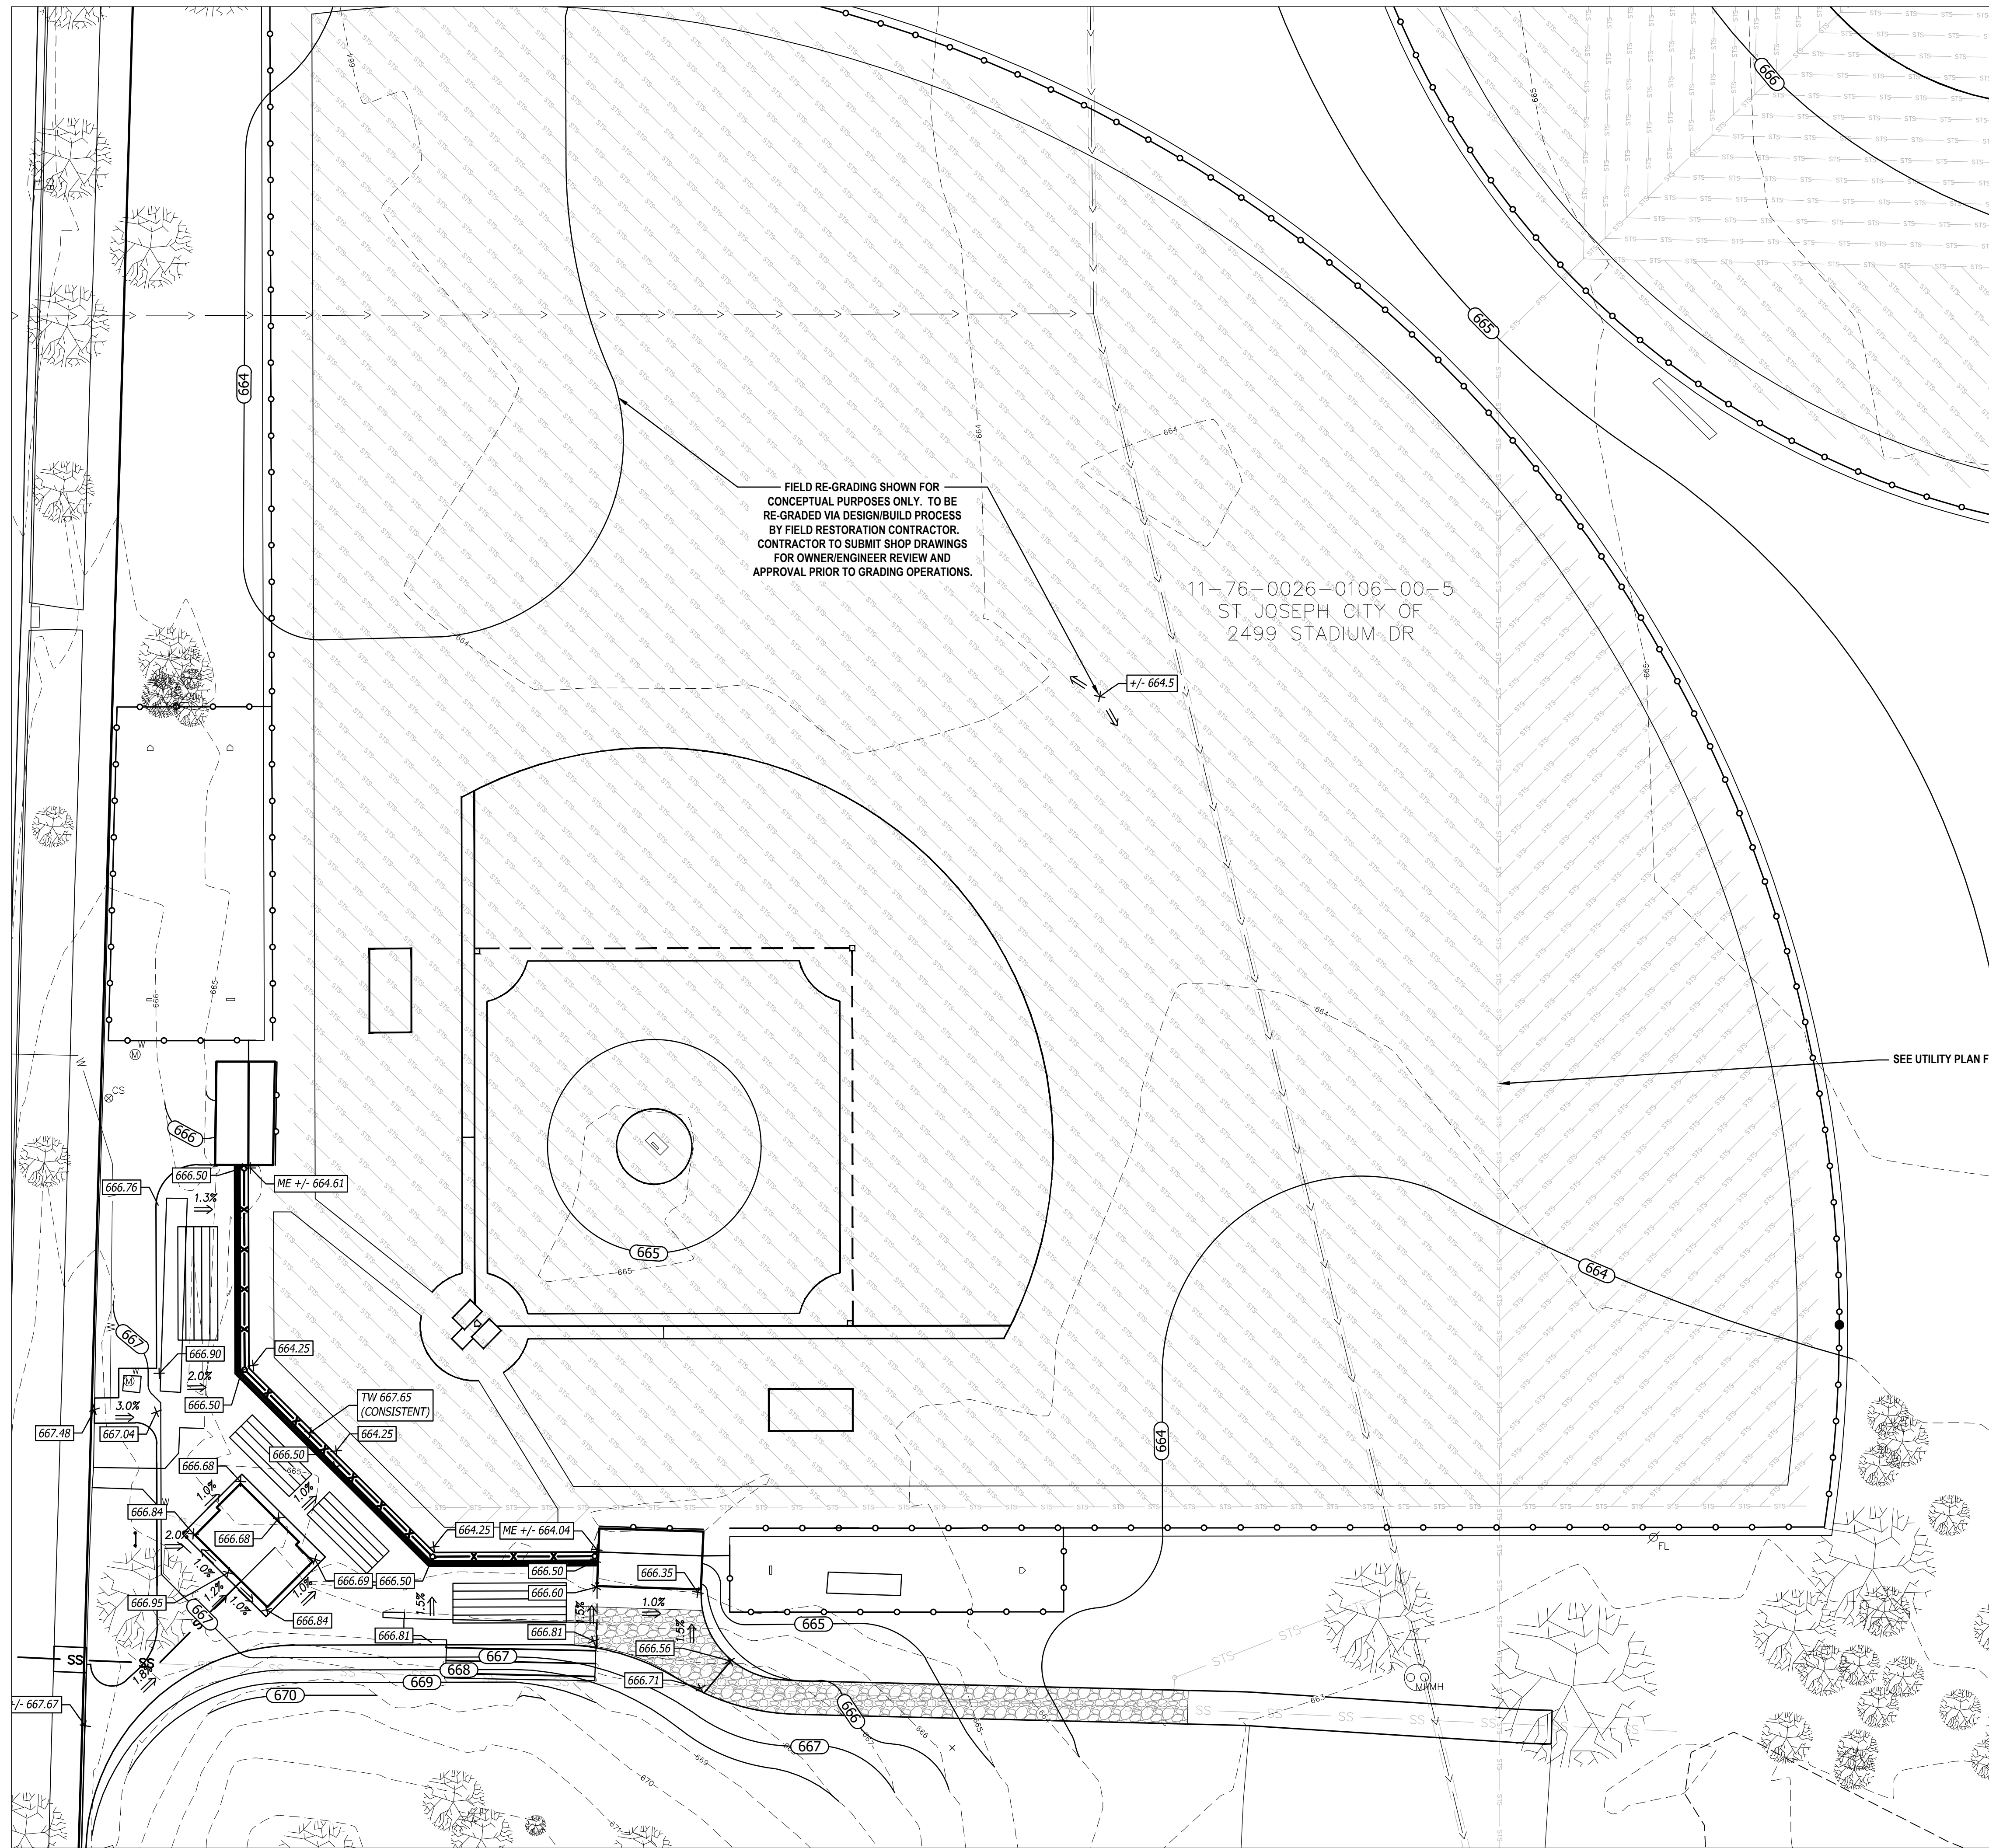

FIELD RE-GRADING SHOWN FOR CONCEPTUAL PURPOSES ONLY. TO BE RE-GRADED VIA DESIGN/BUILD PROCESS BY FIELD RESTORATION CONTRACTOR. CONTRACTOR TO SUBMIT SHOP DRAWINGS FOR OWNER/ENGINEER REVIEW AND APPROVAL PRIOR TO GRADING OPERATIONS.

11-76-0026-0106-00-5
ST. JOSEPH, CITY OF
2499 STADIUM DR

SEE UTILITY PLAN FOR PROPOSED UTILITIES (TYP.)

RECOMMENDED FIELD RESTORATION GRADING CONTRACTOR:
TURF SERVICES
17205 148TH AVE
SPRING LAKE, MI 49456
616-842-4975
TURFSERV@T2K.COM
OR EQUAL


ABONMARCHÉ
 365 West Main Street
 Benton Harbor, MI 49703
 T 269.927.2293
 F 269.927.1017
 abonmarche.com
 Copyright 2011 - ABONMARCHÉ CONSULTANTS, INC.
 Engineers - Architects - Land Surveying
 Richard Harber
 Earl Warren
 South Haven
 Colleen
 Hobart
 Courtney

DICKINSON PARK
SPORTS FIELDS RENOVATIONS
ST JOSEPH, MI

BASEBALL FIELD GRADING
ENLARGEMENT PLAN

SHEET TITLE:
DRAWN BY: TR
DESIGNED BY: TR
PM REVIEW: TR
QA/QC REVIEW:
DATE: 2/3/2022
SEAL:


SIGNATURE:
DATE:

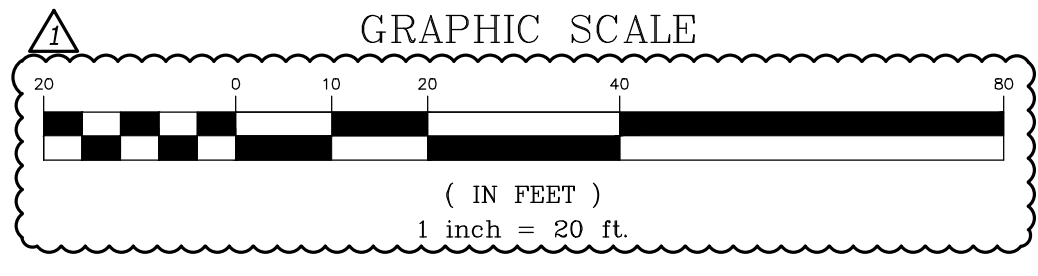

HARD COPY IS INTENDED TO BE 24" X 36" WHEN PLOTTED. SCALE(S) INDICATED AND GRAPHIC QUALITY MAY NOT BE ACCURATE FOR ANY OTHER SIZES
SCALE:
HORIZ: AS NOTED
VERT:
ACI JOB #


21-1558
SHEET NO.

1	ADDENDUM 1	TRR	2/16/2023
NO.	REVISION DESCRIPTION:	BY:	DATE:

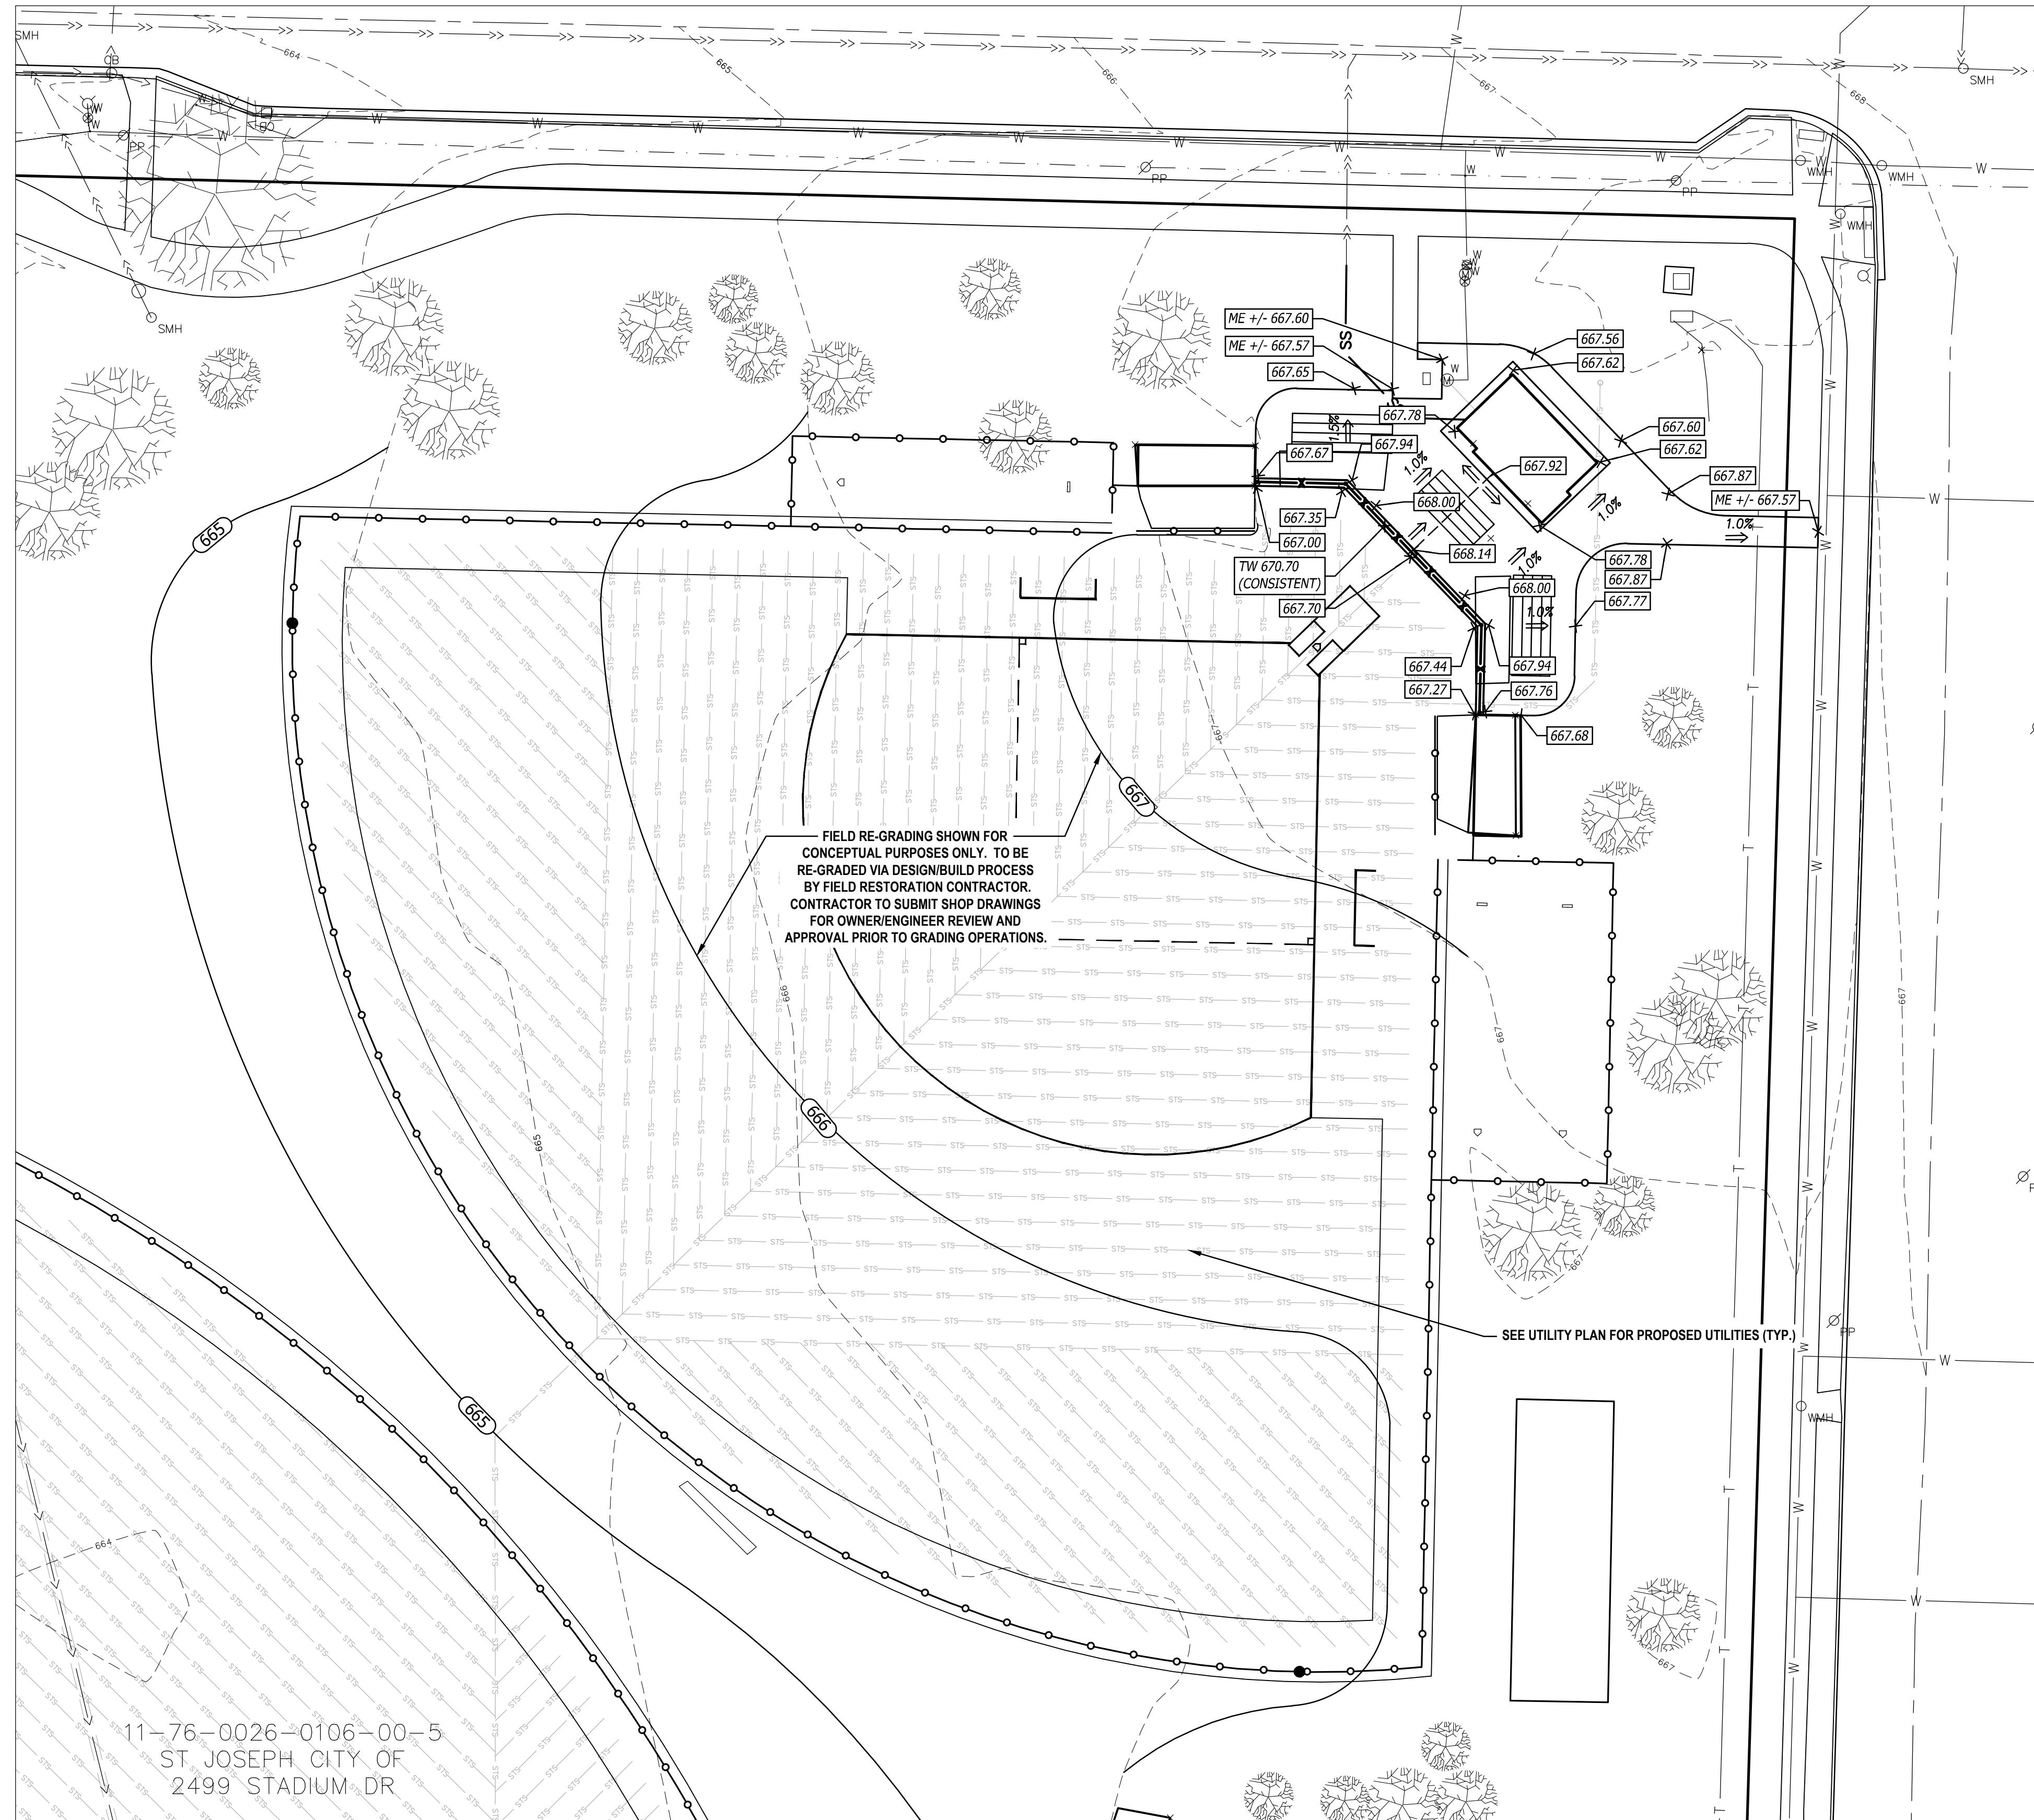

11-76-0026-0106-00-5
ST. JOSEPH CITY OF
2499 STADIUM DR.

RECOMMENDED FIELD RESTORATION GRADING CONTRACTOR:
TURF SERVICES
17205 148TH AVE
SPRING LAKE, MI 49456
616-842-4975
TURFSERV@IQK.COM
OR EQUAL

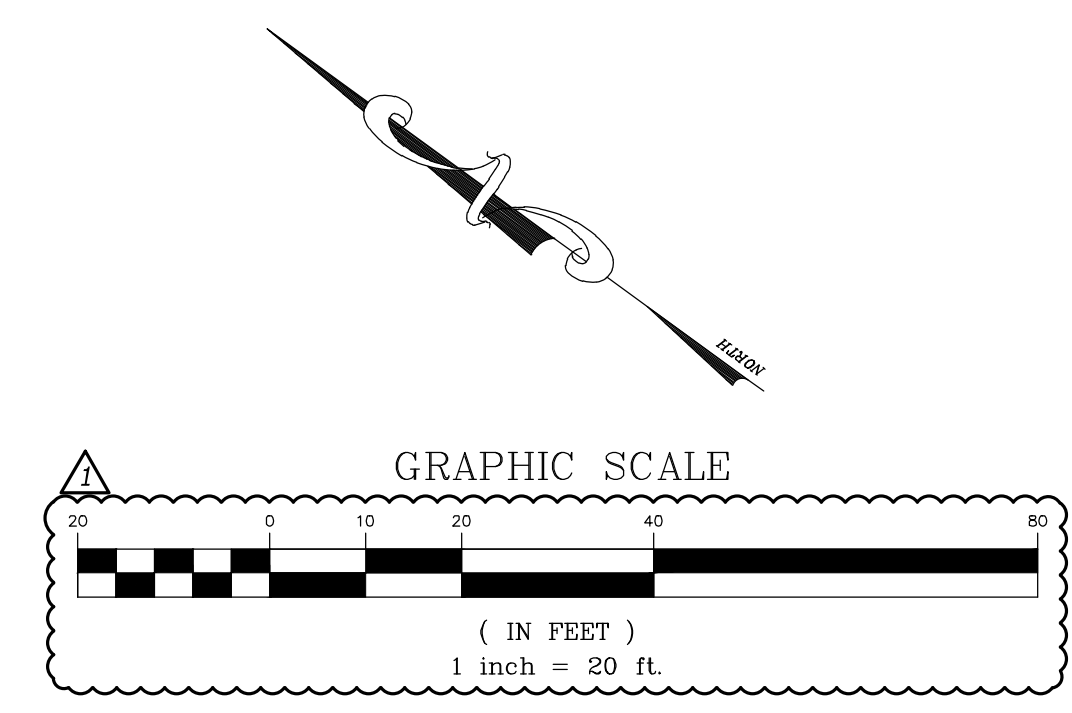

ABONMARCHÉ
Benjamin Bonbrun
Eric Wozniak
Caitlin
Hobart
Lorraine
Engineering - Architecture - Land Surveying
245 West Main Street
Benton Harbor, MI 49023
T 269.927.2293
F 269.927.1017
abonmarche.com
COPYRIGHT 2021 - ABONMARCHÉ CONSULTANTS, INC.

DICKINSON PARK
SPORTS FIELDS RENOVATIONS
ST JOSEPH, MI

SOFTBALL FIELD GRADING
ENLARGEMENT PLAN

SHEET TITLE:
DRAWN BY: TR
DESIGNED BY: TR
PM REVIEW: TR
QA/QC REVIEW:
DATE: 2/3/2022
SEAL:

SIGNATURE:
DATE:

HARD COPY IS INTENDED TO BE 24" X 36" WHEN PLOTTED. SCALE(S) INDICATED AND GRAPHIC QUALITY MAY NOT BE ACCURATE FOR ANY OTHER SIZES


SCALE:
HORIZ: AS NOTED
VERT:

ACI JOB #
21-1558

SHEET NO.
9 of 15

1	ADDENDUM 1	TRR	2/16/2023
NO.	REVISION DESCRIPTION:	BY:	DATE:

C:\Projects\2021\21-1558 Dickinson Park Softball Field Renovations\CAD_C\Drawings\FINAL DESIGN\21-1558 GRADING.dwg, SOFTBALL_21-1558.dwg, 2/16/2023 4:29:38 AM, mmmk, 1:1

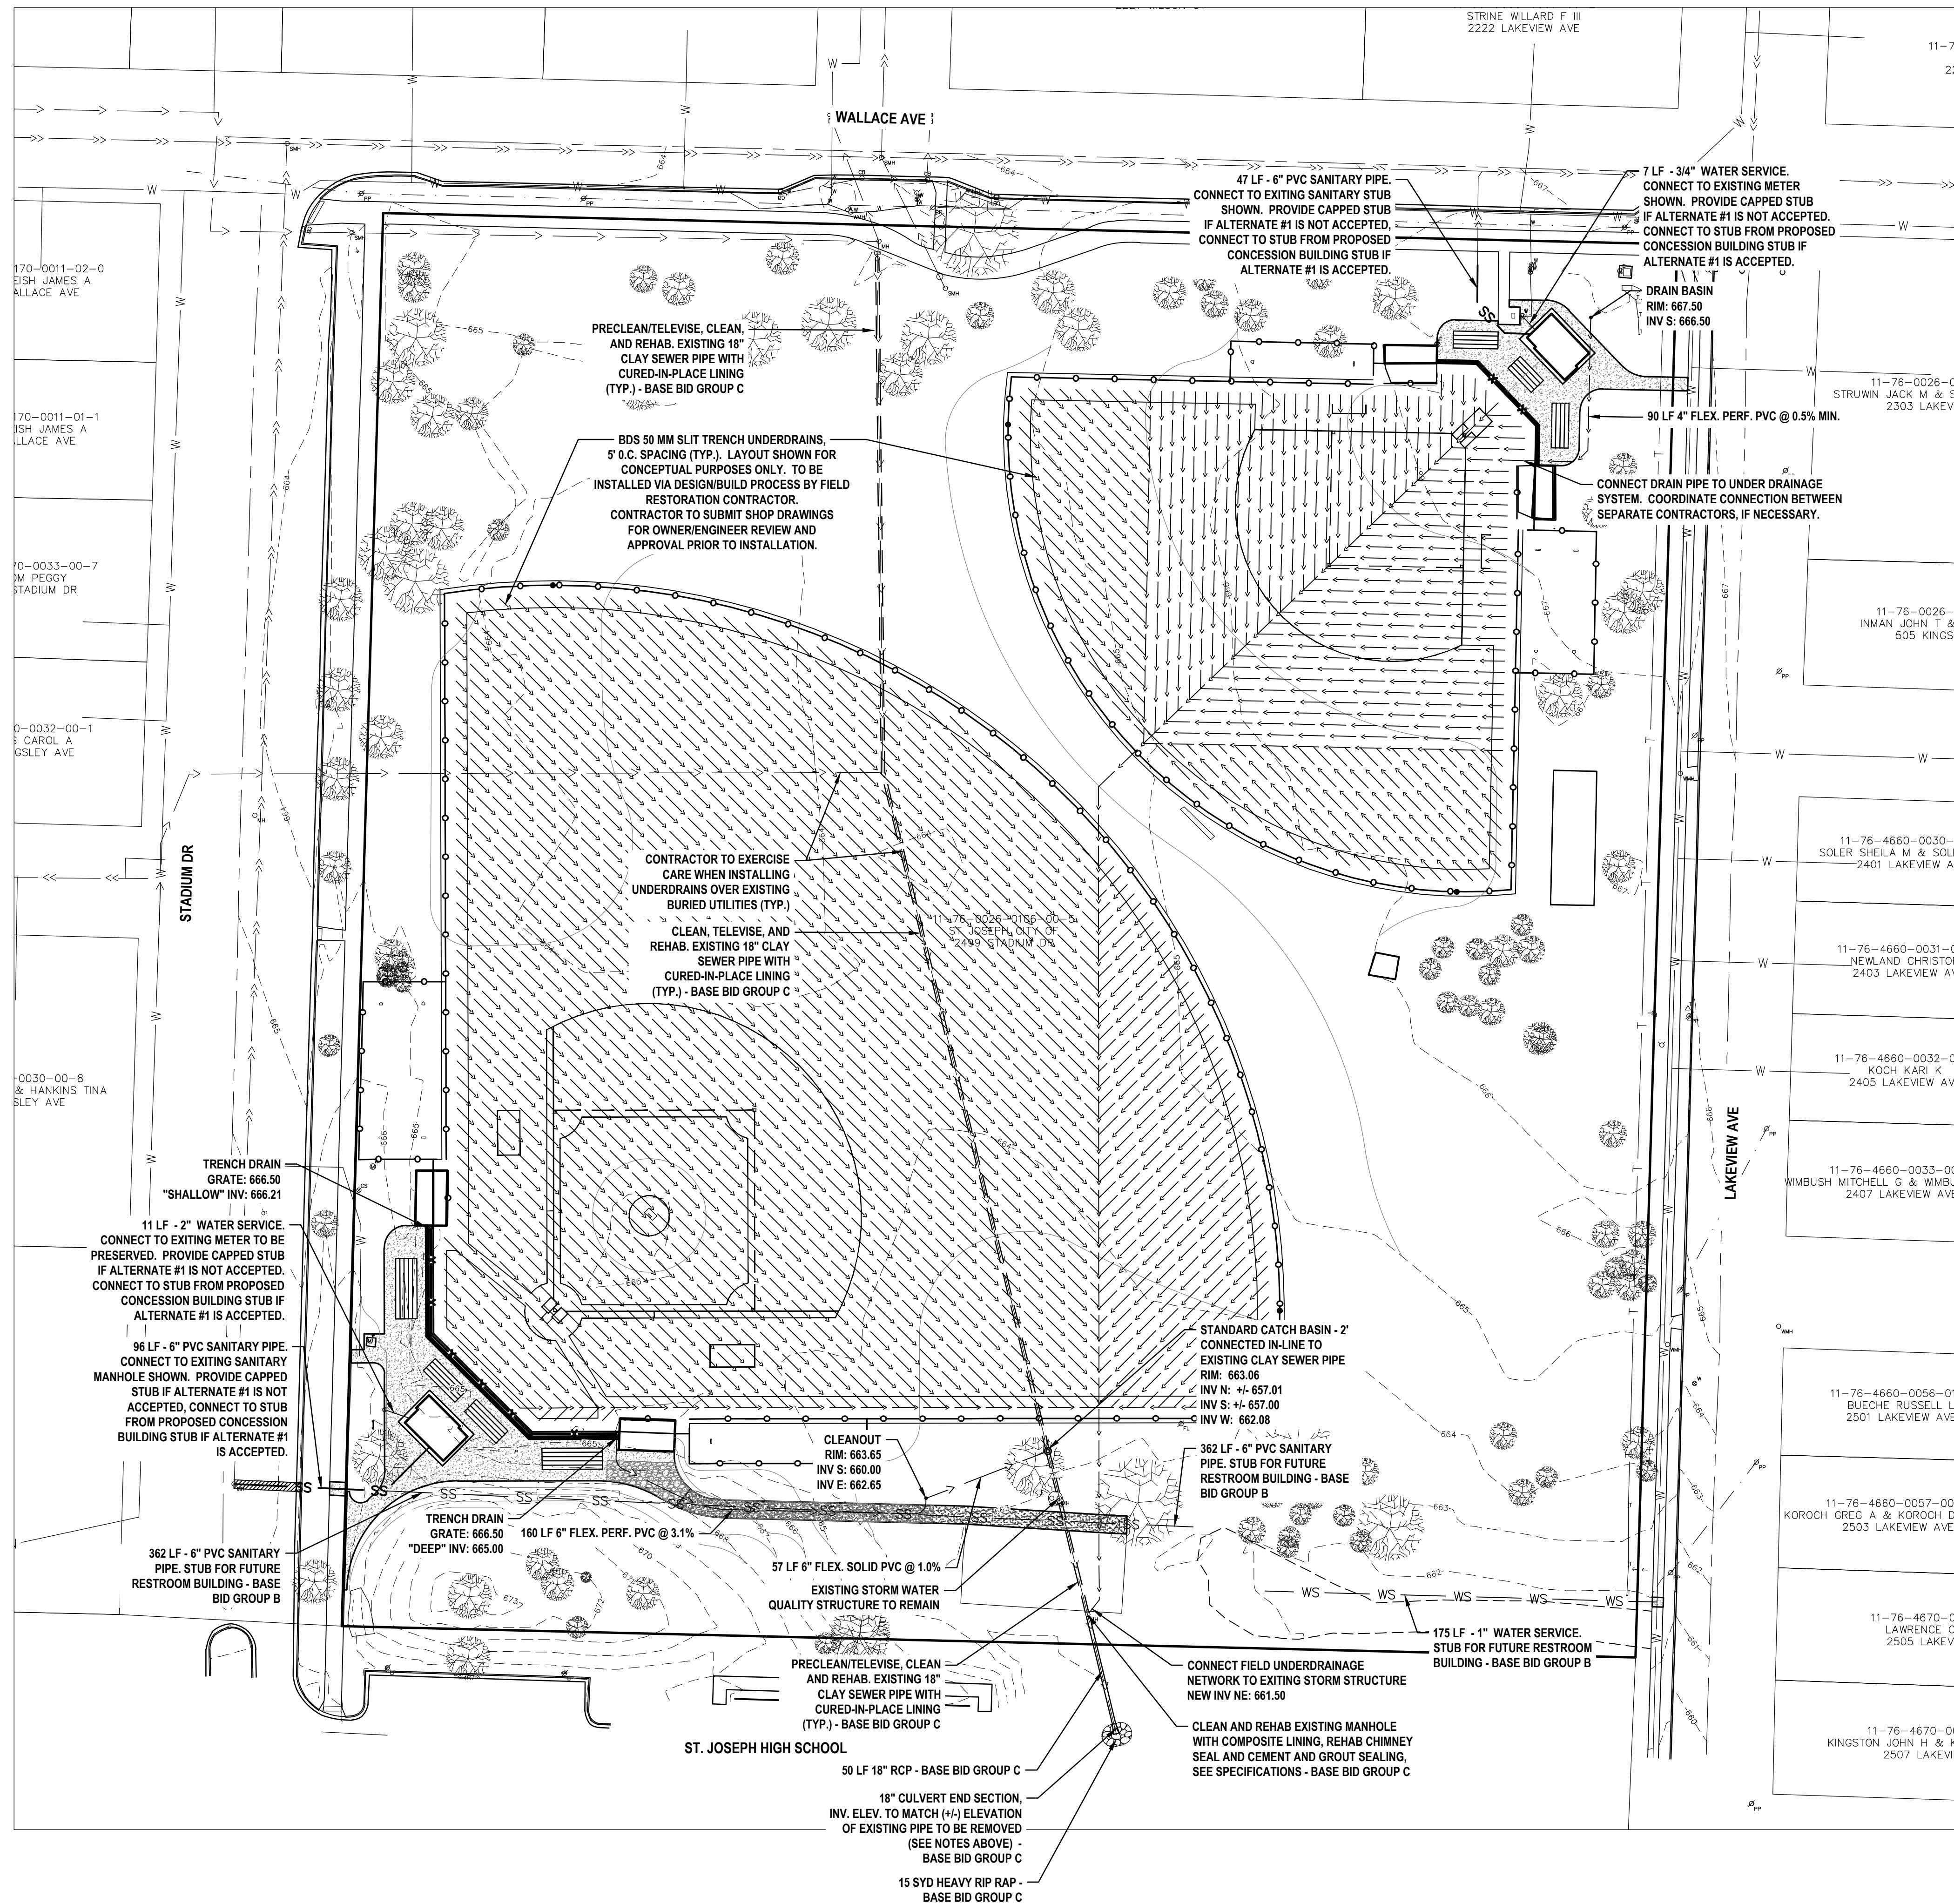

UTILITY NOTES

- IF ALTERNATE #1 IS NOT ACCEPTED, CONTRACTOR TO PROVIDE CAPPED WATER AND SANITARY SEWER STUBS TO THE LOCATIONS SHOWN FOR FUTURE PRESS BOX CONCESSION BUILDING CONNECTIONS.
- ALL UTILITY IMPROVEMENTS SHOWN SHALL BE INCLUDED IN BASE BID GROUP A UNLESS NOTED OTHERWISE.
- SEE SHEET E1.1 FOR PROPOSED ELECTRICAL IMPROVEMENTS
- IF ALTERNATE #1 IS NOT ACCEPTED, CONTRACTOR SHALL PROVIDE ALL NECESSARY UNDERGROUND UTILITY CONDUIT TO ALLOW FOR THE FUTURE CONSTRUCTION OF PRESS BOX / CONCESSION STAND STRUCTURES.
- PROPOSED CULVERT END SECTION ELEVATION SHALL BE BASED ON MATCHING THE ELEVATION OF EXISTING 18" STORM PIPE TO BE REMOVED. SEE REMOVALS PLAN. CONTRACTOR TO RECORD ELEVATION OF EXISTING PIPE OUTFALL, RELATIVE TO ESTABLISHED SITE BENCHMARK. PROVIDE ELEVATION TO ENGINEER FOR CONFIRMATION OF PROPOSED END SECTION ELEVATION.
- DRAIN STRUCTURE TO BE 12" CUSTOM-MADE PVC STRUCTURE
MANUFACTURER: NYLOPLAST
3130 VERONA AVE.
BURLINGTON, GA 30518
770-932-2443
WWW.NYLOPLAST-US.COM
PART#: 7001-110-111
GRATES: 12" DROP IN GRATES
PART#: 7001-110-021
OR EQUAL
INSTALL PER MANUFACTURER'S WRITTEN INSTALLATION INSTRUCTIONS

RECOMMENDED FIELD UNDERDRAINAGE CONTRACTOR:
TURF SERVICES
17205 148TH AVE
SPRING LAKE, MI 49456
616-842-4975
TURFSERV@G2K.COM
OR EQUAL

SHEET TITLE:

DRAWN BY: TR

DESIGNED BY: TR

PM REVIEW: TR

QA/QC REVIEW:

DATE: 2/3/2022

SEAL:

SIGNATURE:

DATE:


HARD COPY IS INTENDED TO BE 24" X 36" WHEN PLOTTED. SCALE(S) INDICATED AND GRAPHIC QUALITY MAY NOT BE ACCURATE FOR ANY OTHER SIZES

SCALE:
HORIZ: AS NOTED
VERT:

ACI JOB #

21-1558

SHEET NO.

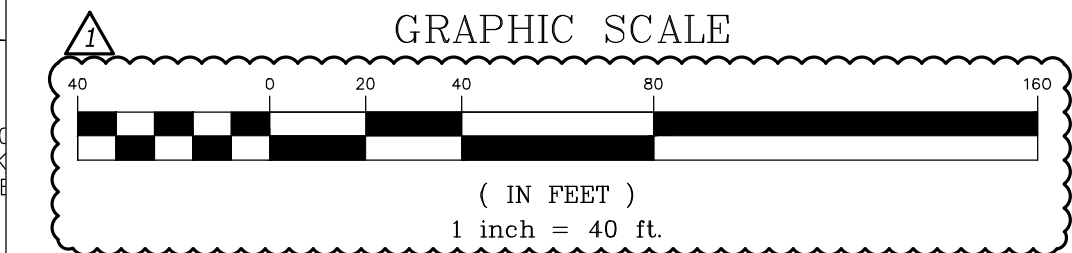

1	ADDENDUM I	TRR	2/16/2023
NO.	REVISION DESCRIPTION:	BY:	DATE:

C:\Projects\2021\21-1558 Dickinson Park Sports Fields Renovations\CAD_C\Site\Drawings\FINAL DESIGN\21-1558 UTILITY.dwg, OVERALL: 2/16/2023 9:47:57 AM, mtdk, 1:1

ADVERTISEMENT FOR BIDS
ST JOSEPH PUBLIC SCHOOLS / CITY OF ST JOSEPH
ST JOSEPH, MI
DICKINSON PARK SPORTS FIELDS RENOVATIONS

General Notice

St Joseph Public Schools (Owner) is requesting Bids for the construction of the following Project:

Dickinson Park Sports Fields Renovations

Bids for the construction of the Project will be received at St. Joseph Public Schools Central Office located at 2580 S Cleveland Ave, St Joseph, MI 49085, until **Friday, March 3, 2023** at 11:00 am local time. At that time the Bids received will be publicly opened and read.

Bids will be for a single prime contract on a unit price basis. Sealed Bids shall bear the project name as well as the name and address of the bidder and shall be submitted to Jennifer Fee, Superintendent.

The Project includes the following Work:

Removal of existing sports fields, fencing, accessory buildings, sidewalks, retaining walls, ~~dugout roofs~~, and bleachers. Construction of new sports fields with fencing, accessory buildings, sidewalks, retaining / backstop walls, backstop netting, ~~dugout roofs~~, field underdrainage, irrigation, sub-surface stormwater detention, fencing, landscape and turf restoration.

Information and Bidding Documents for the Project will be available by 5:00 pm on Friday, February 3, 2023 and can be found at the following designated website: <http://www.abonmarche.com/bids>. There is no fee for registration on the plan holder's list and download of electronic bidding documents. Hard copies are available from the Issuing Office of Abonmarche, 95 West Main Street, Benton Harbor, MI 49022 (269) 927-2295. The fee for obtaining hard copy documents is Twenty-five Dollars (\$25.00). An additional Ten Dollars (\$10.00) will be charged for plans requiring shipping. General Specifications, description and conditions upon which the bid proposal is to be based are on file for examination at the Issuing Office.

A non-mandatory Pre-Bid Meeting will be held at 11:00 am local time on Thursday, February 9, 2023 at St. Joseph High School, 2521 Stadium Dr., St. Joseph, MI 49085,

A certified check, cashier's check or bid bond in an amount equal to five percent (5%) of the total amount of the bid, made payable to St. Joseph Public Schools will be required with each bid as security for the proper execution of the contract. A 100% Labor, Material, and Performance Bond will be required of successful bidder.

No bid shall be withdrawn for a period of ninety (90) days after the scheduled opening without consent of the OWNER. The Owner reserves the right to reject any and all bids, waive any informality in bidding or to accept the bid, consistent with law, which best serves the interest of the Owner.

All inquiries shall be directed to Abonmarche, attn.: Tom Runkle at Phone (269) 927-2295, Fax: (269) 927-1017 or via email: trunkle@abonmarche.com. Technical questions must be submitted via email and shall be entitled "Dickinson Park Sports Fields Renovations – RFI."

BID BOND (PENAL SUM FORM)

<p>Bidder</p> <p>Name: _____</p> <p>Address (<i>principal place of business</i>): _____</p>	<p>Surety</p> <p>Name: _____</p> <p>Address (<i>principal place of business</i>): _____</p>
<p>Owner</p> <p>Name: St Joseph Public Schools / City of St. Joseph</p> <p>Address (<i>principal place of business</i>): 2580 S Cleveland Ave St Joseph, MI 49085</p>	<p>Bid</p> <p>Project (<i>name and location</i>): Dickinson Park Sports Fields Renovations</p> <p>Bid Due Date: March 3, 2023</p>
<p>Bond</p> <p>Penal Sum: _____</p> <p>Date of Bond: _____</p>	
<p>Surety and Bidder, intending to be legally bound hereby, subject to the terms set forth in this Bid Bond, do each cause this Bid Bond to be duly executed by an authorized officer, agent, or representative.</p>	
<p>Bidder</p> <p style="text-align: center;">_____ <i>(Full formal name of Bidder)</i></p>	<p>Surety</p> <p style="text-align: center;">_____ <i>(Full formal name of Surety) (corporate seal)</i></p>
<p>By: _____ <i>(Signature)</i></p>	<p>By: _____ <i>(Signature) (Attach Power of Attorney)</i></p>
<p>Name: _____ <i>(Printed or typed)</i></p>	<p>Name: _____ <i>(Printed or typed)</i></p>
<p>Title: _____</p>	<p>Title: _____</p>
<p>Attest: _____ <i>(Signature)</i></p>	<p>Attest: _____ <i>(Signature)</i></p>
<p>Name: _____ <i>(Printed or typed)</i></p>	<p>Name: _____ <i>(Printed or typed)</i></p>
<p>Title: _____</p>	<p>Title: _____</p>
<p><i>Notes: (1) Note: Addresses are to be used for giving any required notice. (2) Provide execution by any additional parties, such as joint venturers, if necessary.</i></p>	

1. Bidder and Surety, jointly and severally, bind themselves, their heirs, executors, administrators, successors, and assigns to pay to Owner upon default of Bidder the penal sum set forth on the face of this Bond. Payment of the penal sum is the extent of Bidder's and Surety's liability. Recovery of such penal sum under the terms of this Bond will be Owner's sole and exclusive remedy upon default of Bidder.
2. Default of Bidder occurs upon the failure of Bidder to deliver within the time required by the Bidding Documents (or any extension thereof agreed to in writing by Owner) the executed Agreement required by the Bidding Documents and any performance and payment bonds required by the Bidding Documents.
3. This obligation will be null and void if:
 - 3.1. Owner accepts Bidder's Bid and Bidder delivers within the time required by the Bidding Documents (or any extension thereof agreed to in writing by Owner) the executed Agreement required by the Bidding Documents and any performance and payment bonds required by the Bidding Documents, or
 - 3.2. All Bids are rejected by Owner, or
 - 3.3. Owner fails to issue a Notice of Award to Bidder within the time specified in the Bidding Documents (or any extension thereof agreed to in writing by Bidder and, if applicable, consented to by Surety when required by Paragraph 5 hereof).
4. Payment under this Bond will be due and payable upon default of Bidder and within 30 calendar days after receipt by Bidder and Surety of written notice of default from Owner, which notice will be given with reasonable promptness, identifying this Bond and the Project and including a statement of the amount due.
5. Surety waives notice of any and all defenses based on or arising out of any time extension to issue Notice of Award agreed to in writing by Owner and Bidder, provided that the total time for issuing Notice of Award including extensions does not in the aggregate exceed 120 days from the Bid due date without Surety's written consent.
6. No suit or action will be commenced under this Bond prior to 30 calendar days after the notice of default required in Paragraph 4 above is received by Bidder and Surety, and in no case later than one year after the Bid due date.
7. Any suit or action under this Bond will be commenced only in a court of competent jurisdiction located in the state in which the Project is located.
8. Notices required hereunder must be in writing and sent to Bidder and Surety at their respective addresses shown on the face of this Bond. Such notices may be sent by personal delivery, commercial courier, or by United States Postal Service registered or certified mail, return receipt requested, postage pre-paid, and will be deemed to be effective upon receipt by the party concerned.
9. Surety shall cause to be attached to this Bond a current and effective Power of Attorney evidencing the authority of the officer, agent, or representative who executed this Bond on behalf of Surety to execute, seal, and deliver such Bond and bind the Surety thereby.
10. This Bond is intended to conform to all applicable statutory requirements. Any applicable requirement of any applicable statute that has been omitted from this Bond will be deemed to be included herein as if set forth at length. If any provision of this Bond conflicts with any applicable statute, then the provision of said statute governs and the remainder of this Bond that is not in conflict therewith continues in full force and effect.
11. The term "Bid" as used herein includes a Bid, offer, or proposal as applicable.